



SCALE: 1" = 200'

Find 1/2" IR. MON. OVER CONC. MON.


E. W. 2nd ST. N 0° 24' 14" W 1320.97' (1320.4')

Find IR OVER CONC. MON.

N 89° 43' W 1337.75' (1337.4')

BEARING BASE 1935 TAMBLYN PLAT

Find 1/2" IR. MON. UNKNOWN

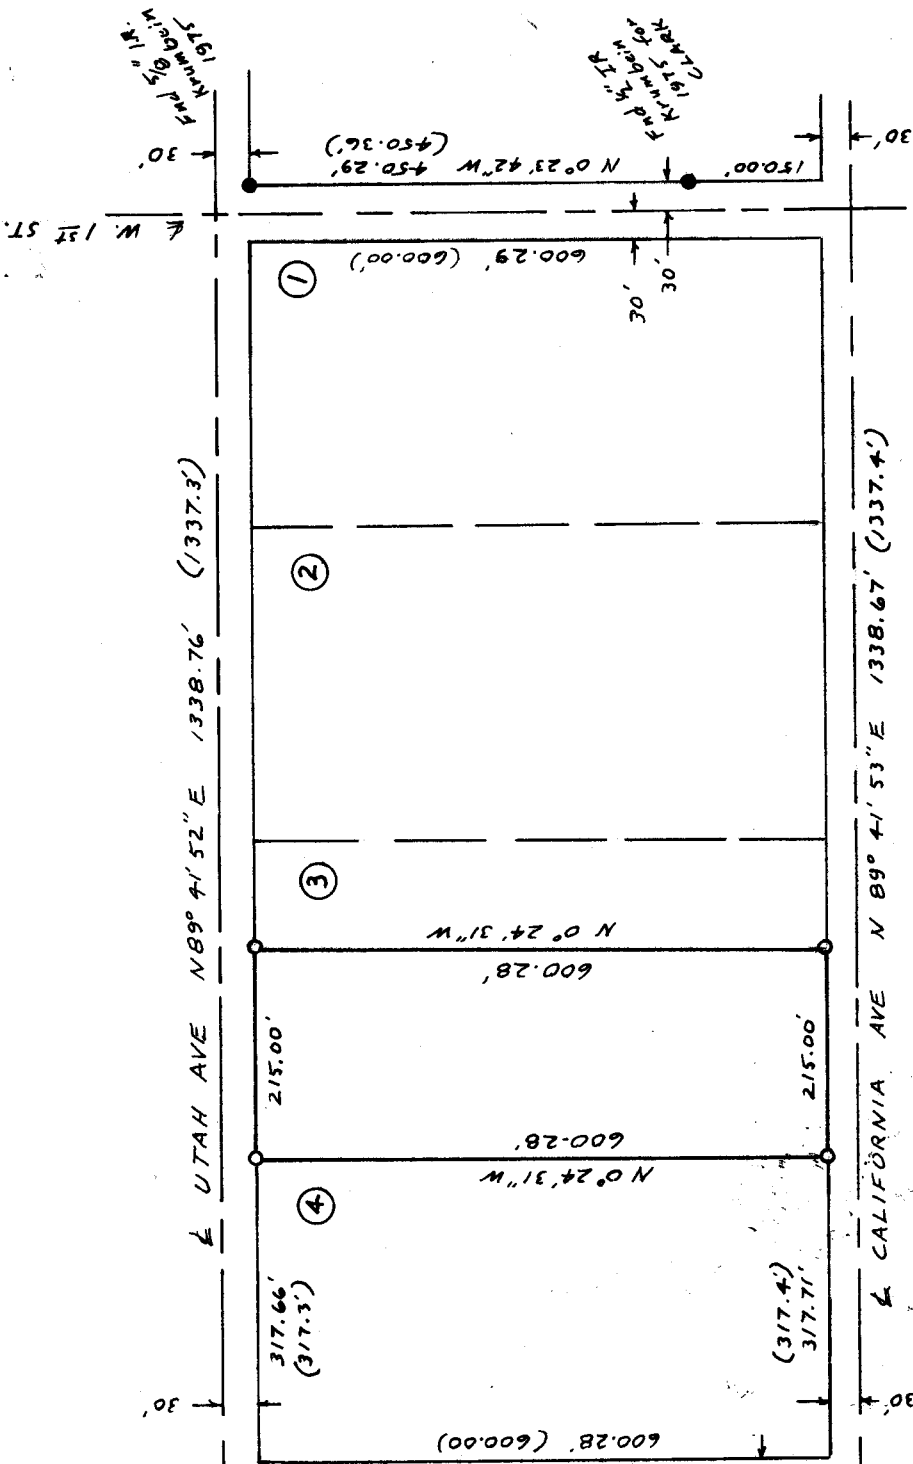

REGISTERED PROFESSIONAL LAND SURVEYOR

G. Dennis Edwards

OREGON JULY 18, 1871 G. DENNIS EDWARDS 951

SURVEY FOR STEVE SEED

IN B1/4 Sec. 5W. NE 1/4 Sec. 25, T 5N, R 26E, WM. MORROW CO., OREGON

Monuments Found 3/30/82 Job # 58203017

0 1/2" I. Rods Set

(000) of Record

EDWARDS SURVEYING HERMISTON, OR. 567-3336