A-624-K-6

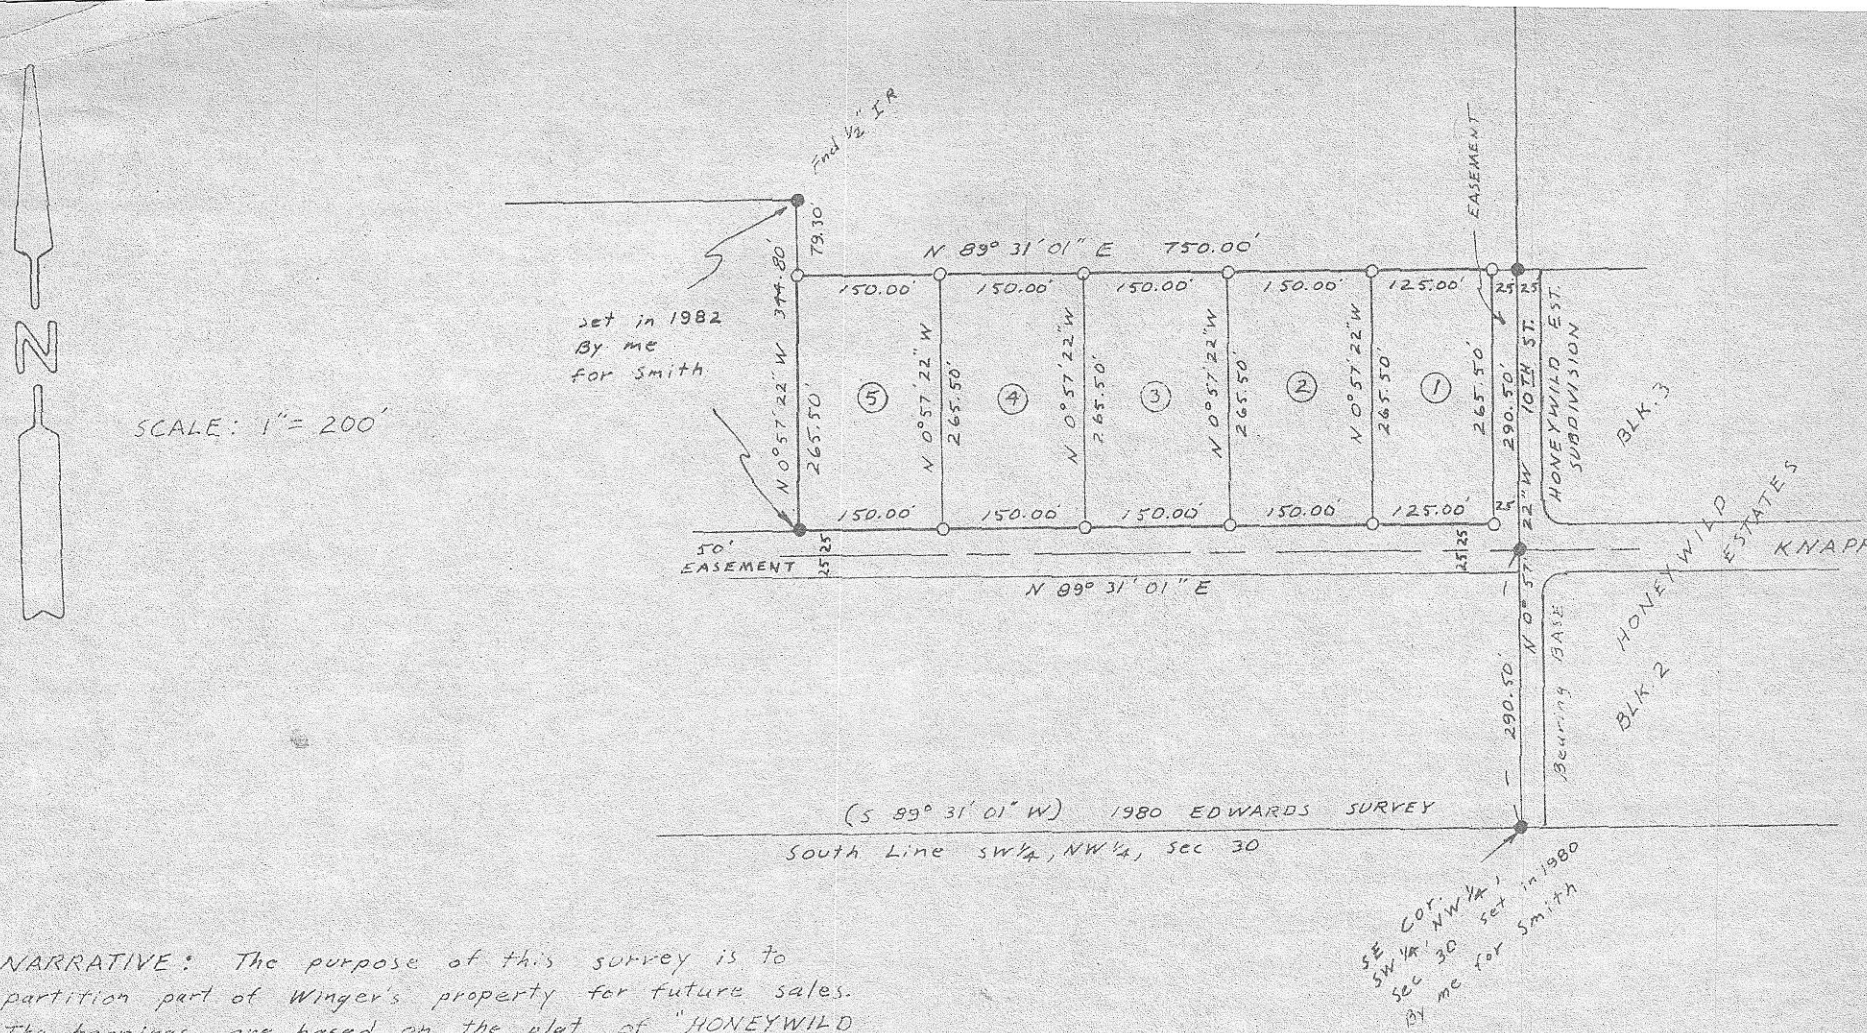

NARRATIVE: The purpose of this survey is to partition part of Winger's property for future sales. The bearings are based on the plat of "HONEYWILD ESTATES". The boundary of "HONEYWILD ESTATES" was set based on the subdivision of Sec. 30 by me for Smith, et al, in 1980.

REGISTERED PROFESSIONAL LAND SURVEYOR

G. Dennis Edwards

OREGON
G. DENNIS EDWARDS

RECEIVED BY
Morrow County Surveyor
Date 6-21-83
Rec'd By M.L.D.
No. A-624-K

SURVEY For ED WINGER
in NW1/4, Sec. 30, T5N, R27E, W.M., Morrow Co., OR.
3/4/83 Job # S8102028 (000) of record
● 5/8" IR fnd. ○ 1/2" IR set

EDWARDS SURVEYING P.O. Box 763
567-3336 HERMISTON, OREGON