


- SET 5/8" IRON ROD & CAP
- FND MON. AS NOTED.

NARRATIVE

THE PURPOSE OF THIS SURVEY WAS TO SET THE PROPERTY CORNERS TO LOTS 1 & 2 BLK 31.

MONUMENTS THAT DENNY EDWARDS FOUND AND USED FOR HIS SURVEY OF THE 7TH DAY ADVENTIST CHURCH PROPERTY DATED 3-1-82 WERE FOUND ALONG WITH 3-1/2" IRON RODS ON THE NORTH SIDE OF OREGON AVE. THAT CHECKED OUT TO MATCH EACH OTHER. THESE MONUMENTS AND EDWARDS BEARING OF 4TH ST WERE USED TO SET THE PROPERTY CORNERS.

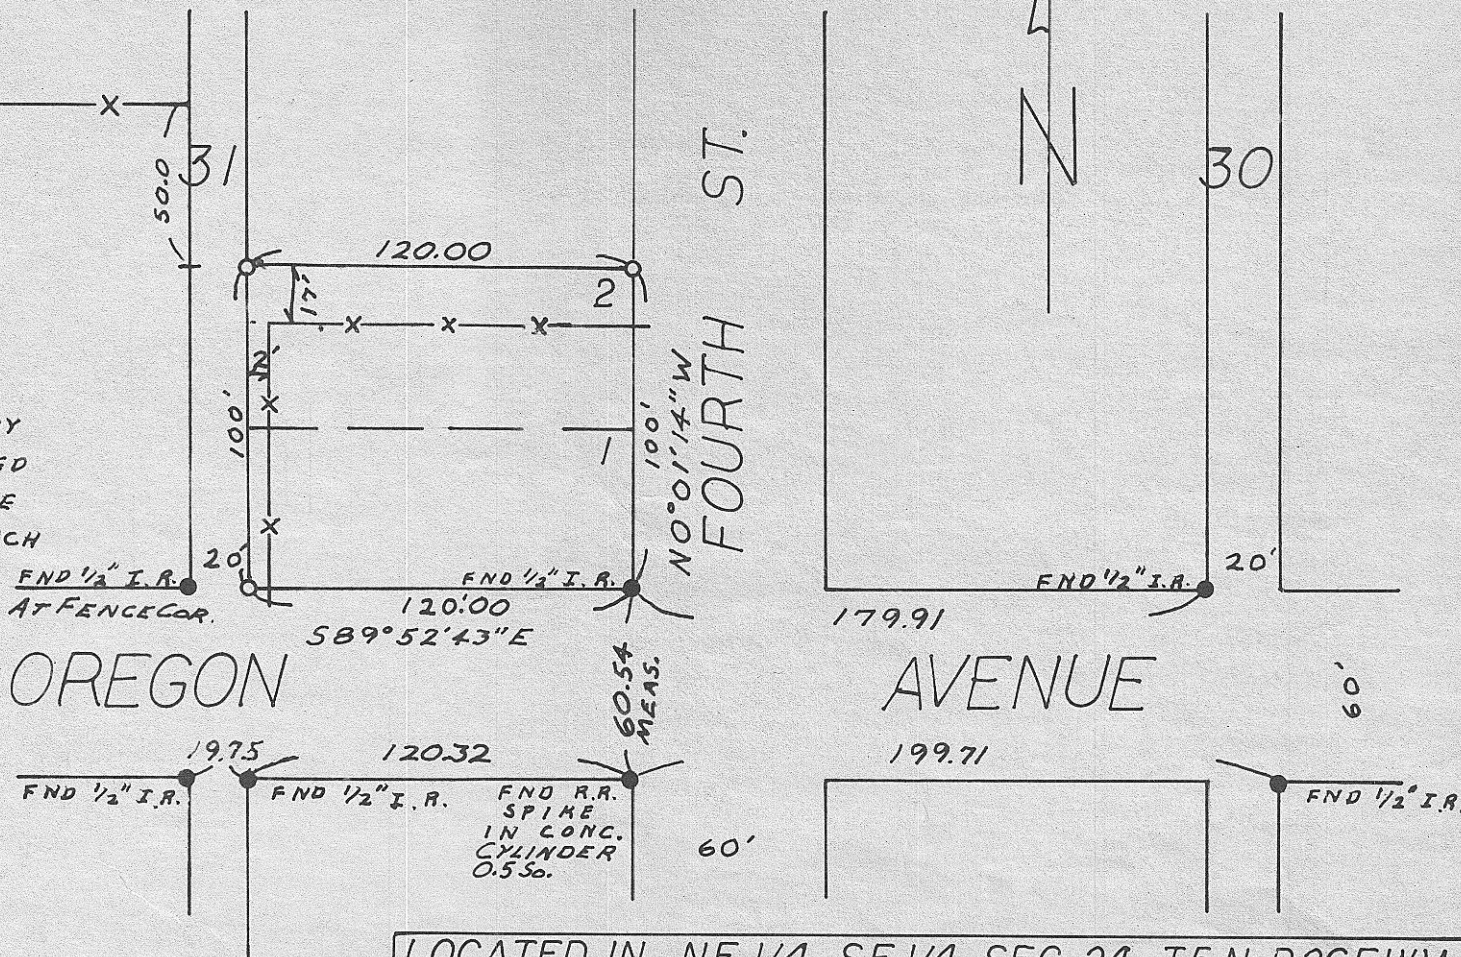

OREGON

AVENUE

FOURTH ST.

A-655-K-62

RECEIVED BY

Morrow County Surveyor

Date 1-30-84

Rec'd By MLD

No. A-655-K

REGISTERED PROFESSIONAL LAND SURVEYOR

Earl D. King

OREGON
 DEC. 4, 1978
 EARL D. KING

LOCATED IN NE 1/4, SE 1/4, SEC. 24, T.5 N., R.26 E. W.M. BLK. 31, LOTS 1 & 2

SCALE: 1" = 60' DRAWN BY: RJM
 DATE: 12-15-83 REVISED:

SURVEY FOR LUKE MAYNARD

R&M SURVEYOR & CONSULTANTS, INC.
 P.O. BOX 395, BOARDMAN, ORE.

DRAW. NO.
 83-1212-A