

GILMORE STREET

E. TERRACE DR.

AUGUST ST.


GILMORE

NORTH (RECORD)

MRS. THORP

W.C. HASTINGS

BASIS OF BEARING
GILMORE ST. AS LOCATED

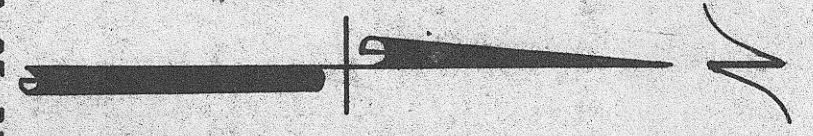

LEGEND

- Found Monuments
- Set 5/8" x 30" iron pin

REGISTERED
OREGON
LAND SURVEYOR

John Day

JULY 10, 1964
DUANE L. GRIFFITH
044

BAGETT-GRIFFITH-FERGUSON	
John Day, Oregon MAP OF SURVEY	
MORROW COUNTY, OREGON	
LOTS 2-3-4 BLOCK 9	
JONES FIRST ADDITION TO HEPPNER	
SURVEYED FOR	W.C. HASTINGS
SURVEYED BY	D.I.G. & D.M.F.
Scale: 1" = 30'	Drawn by: T.D.G.
	SEPT. 1970
	SEPT. 1970

Robert D. Baggett
Morrow County Surveyor