


CURVE DATA
 C.R. = 6°
 Δ = 16°44'
 T = 140.50'
 C.C. = 278.00'
 R = 955.31'

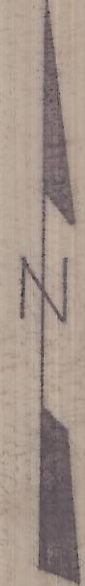

NOTE:
 BEARING BASED ON PLAT OF
 SHIPLEY'S ADDITION. MORGAN STREET
 IS TO BE VACATED.

- LEGEND:**
- FOUND PIN
 - SET 5/8" PIN

REGISTERED
 PROFESSIONAL
 LAND SURVEYOR
David H. Krumbein
 DAVID H. KRUMBEIN
 1933

KRUMBEIN ENGINEERING CO. ENGINEERS - SURVEYORS - PLANNERS 216 S.E. 1st, Pendleton, Oregon SURVEY FOR LARRY PROCK — FEED STORE SEC. 27 T2S, R26 E HEPPNER, OREGON	SCALE, 1" = 50'
	DATE 7-15-76
	DRN. BY T.E.H.
	CKD. BY
	DRNG. NO. 76-37 B