Survey for Mark Morris in S.W. 1/4 Sec 35, T 5 N, R 26 E, W.M. Morrow County, Oregon

9/2/75

Denny Edwards P.O. Box 805, Hermiston

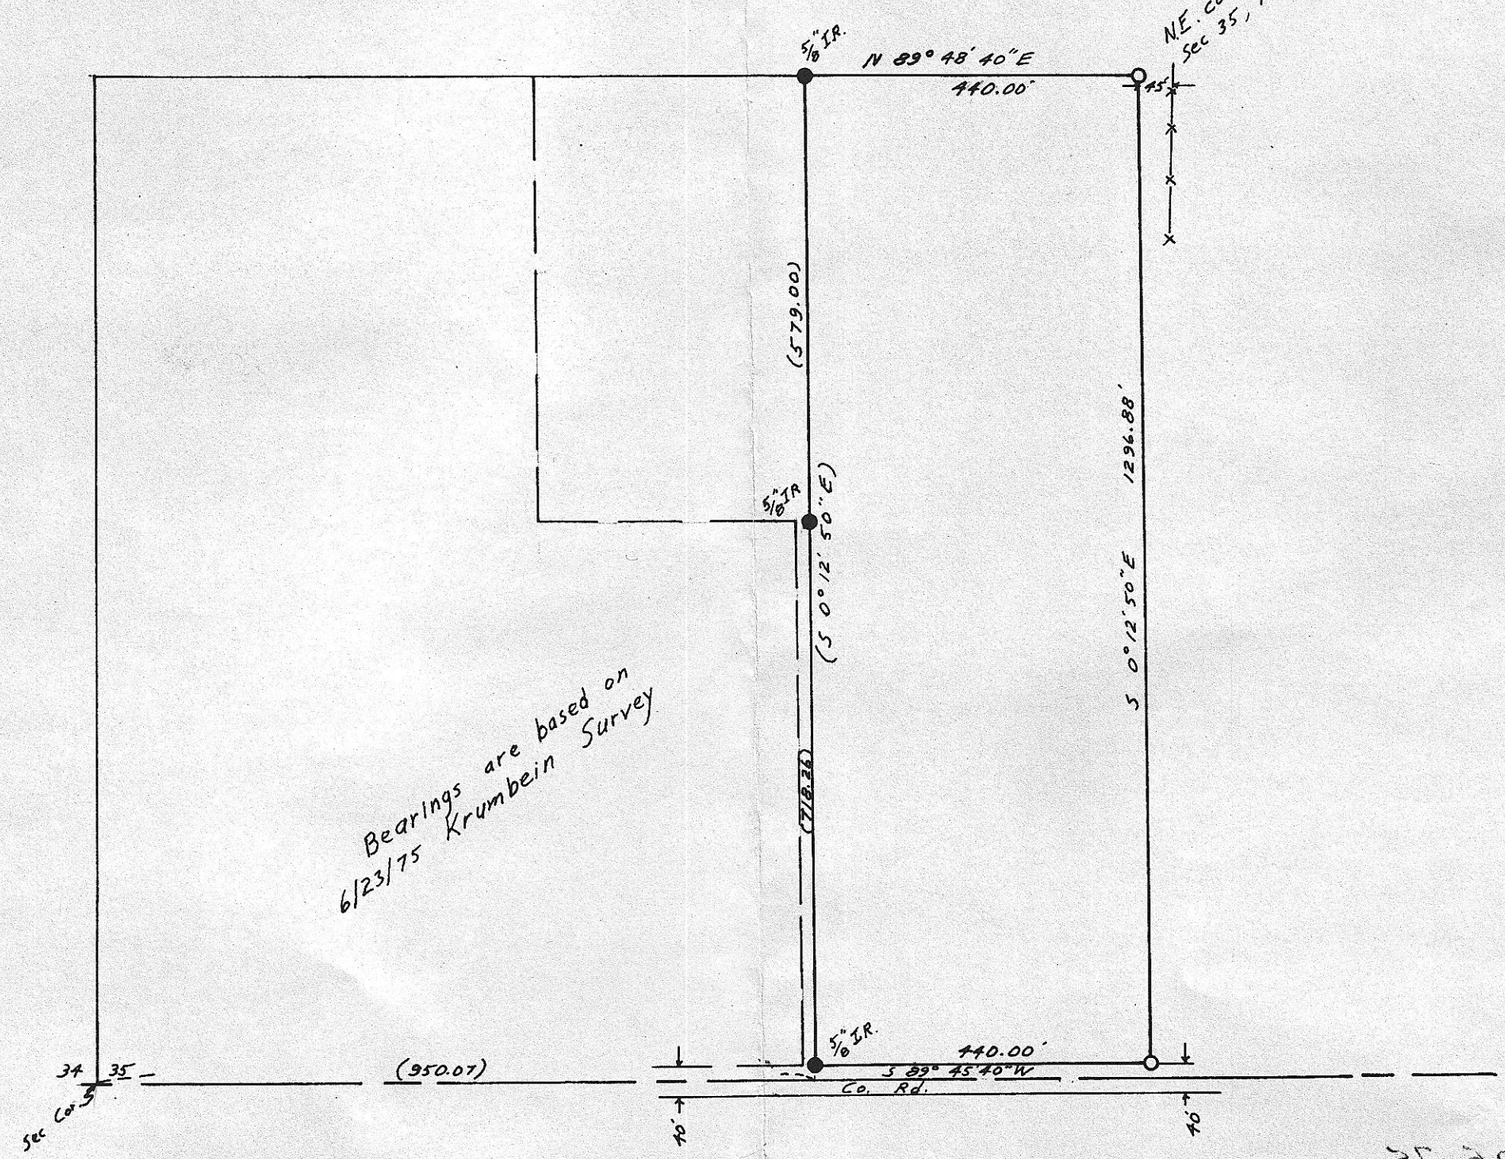

Scale 1" = 200'

● Monuments Fnd.

○ 5/8" I. Rods Set

(000) of record

REGISTERED PROFESSIONAL LAND SURVEYOR

G. Dennis Edwards

OREGON
JULY 16, 1971
G. DENNIS EDWARDS
951

7/24 9-25-75
Morris Farms Co. Ltr.
for Bobby Bloodworth
Plat