

# OFFICIAL SURVEY

PETITION OF  
ADOLF SKOUBO  
FOR THE ESTABLISHMENT  
OF THE SOUTH BOUNDARY


# 45 K

NW  $\frac{1}{4}$  NE  $\frac{1}{4}$  SEC. 15 T4N R25E W.M.

Scale 1" = 400'  
Bearings True  
Aug. 1 - 1930

East 2640.0

East 2640.0

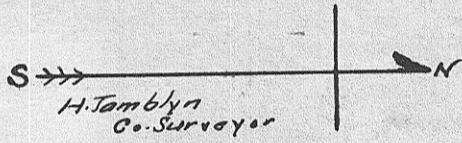

Center Sect. 15  
Point Set

1327.8

S0°39'E Cor. Est.

1324.8

Cor. Fd.

NW  $\frac{1}{4}$  NE  $\frac{1}{4}$

1330.3

1330.3

S89°57'E Cor. Est.

N29°44'W  
2681.0

Cor. Fd.

1322.9

N0°15'E

1322.9

Point Set.

Cor. Fd.