


T. 3 N.  
T. 2 N.

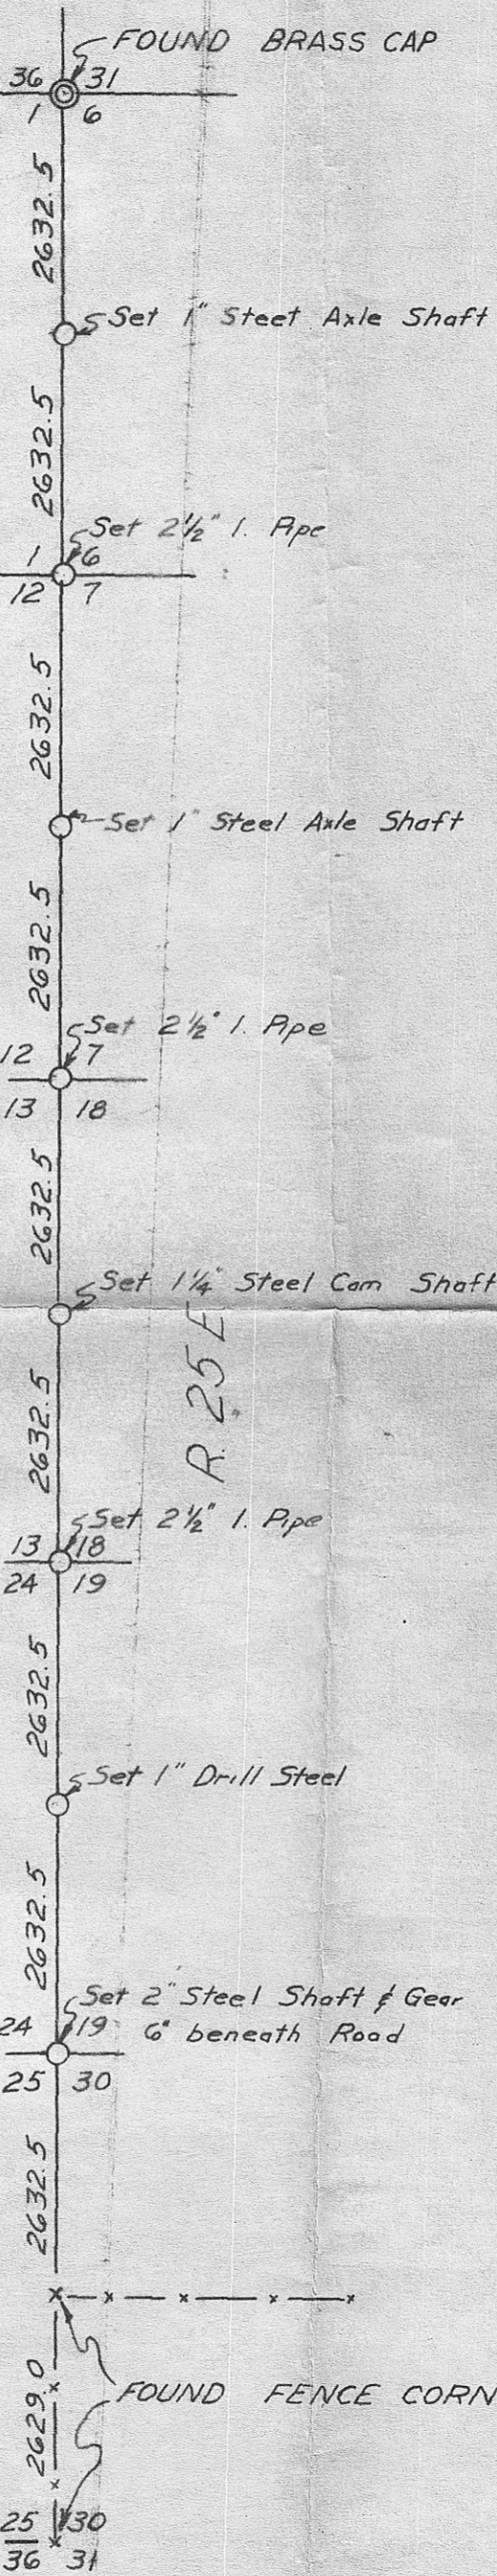

Note: Set 1/2" I. Pins as references to Section Corner  
 Corner  $\frac{24}{25} \frac{19}{30}$  Pin #1 bears S65°W, 68°  
 Pin #2 bears S75°E, 118°

REGISTERED  
OREGON  
LAND SURVEYOR

*Leland H. Ascher*  
 JULY 10, 1964  
 LELAND H. ASCHER  
 635

HAYES AND HARRIS			
SURVEY FOR THE BOEING COMPANY			
T. 2 N., R. 24 & 25 E.W.M.			
SCALE	DATE	DRN. BY	DRNG. NO.
1"=2000'	3-18-65	LHA	65-166-A

B-50-K-103

B-50-K