


AREA = 389.06

DETAIL
NW 1/4, NW 1/4, SECTION 20, TAN. R25E, W1M
SCALE 1"=200'

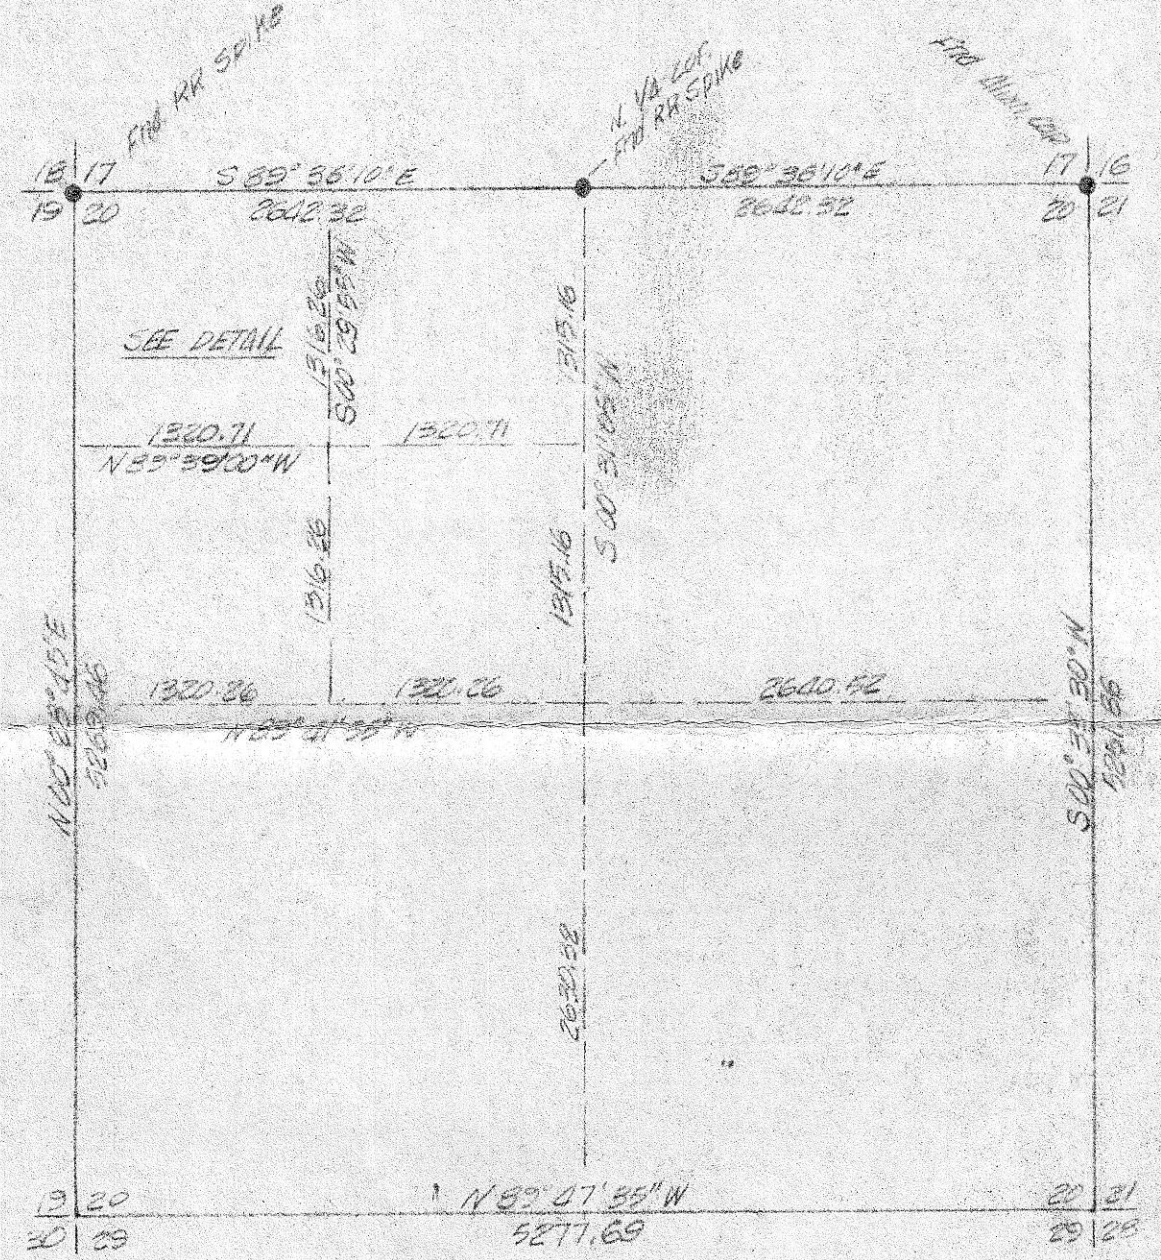

SECTION 20, TAN. R25E, W1M
SCALE 1"=1000'
NOTE: SEE KRUMBEIN ENGINEER DRAWING NO. 76-12C FOR THE ESTABLISHMENT OF THE EXTERIOR DIMENSIONS OF SECTION 20.

REGISTERED
PROFESSIONAL
LAND SURVEYOR

David H. Krumbein
OREGON
JULY 17, 1970
DAVID H. KRUMBEIN
933

KRUMBEIN ENGINEERING CO. ENGINEERS - SURVEYORS - PLANNERS 216 S.E. 1st, Pendleton, Oregon	SCALE AS SHOWN
	DATE 2-20-76
SURVEY OF SECTION 20, TAN. R25E FOR EARL TRUDEAU BOARDMAN, OREGON	DRN. BY JHB
	CKD. BY DHK
	DRNG. NO. 76-15B