


BASIS OF BEARING
DEED DESCRIPTION CALLS

REFERENCE MATERIAL
KRUMBEIN ENGINEERING'S
BREAK DOWN OF SECTION
15, T4N, R25E, W.M.

- LEGEND**
- ◆ FOUND MONUMENT OF RECORD
 - FOUND UNRECORDED MONUMENTS
 - FOUND 1/2" STEEL PIN
 - SET 5/8" STEEL PIN WITH CAP MARKED A.P.&A.
 - SET P.K. NAIL
 - () RECORD DATA
- PROPERTY LINE ————
- SECTION LINE —————
- FENCE LINE — x — x — x —

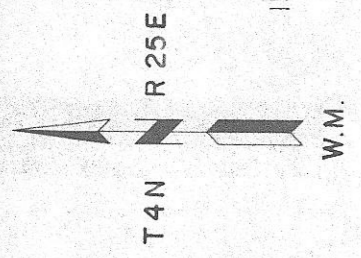

PROPERTY SURVEY LOCATED IN THE SE. 1/4 OF THE NE. 1/4 OF SECTION 16, T4N, R25E, W.M. FOR: LESTER MOEN		SHEET NO
SCALE:	 Anderson Perry & Associates, Inc. engineering • surveying • materials testing LA GRANDE & ENTERPRISE, OREGON	
DATE:		
JUL. 1977		