
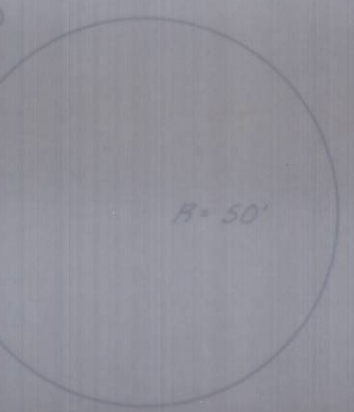


- Denotes Mon. found
- Denotes Mon. set

Note: Monuments found and set are in accordance with Plat Monuments.

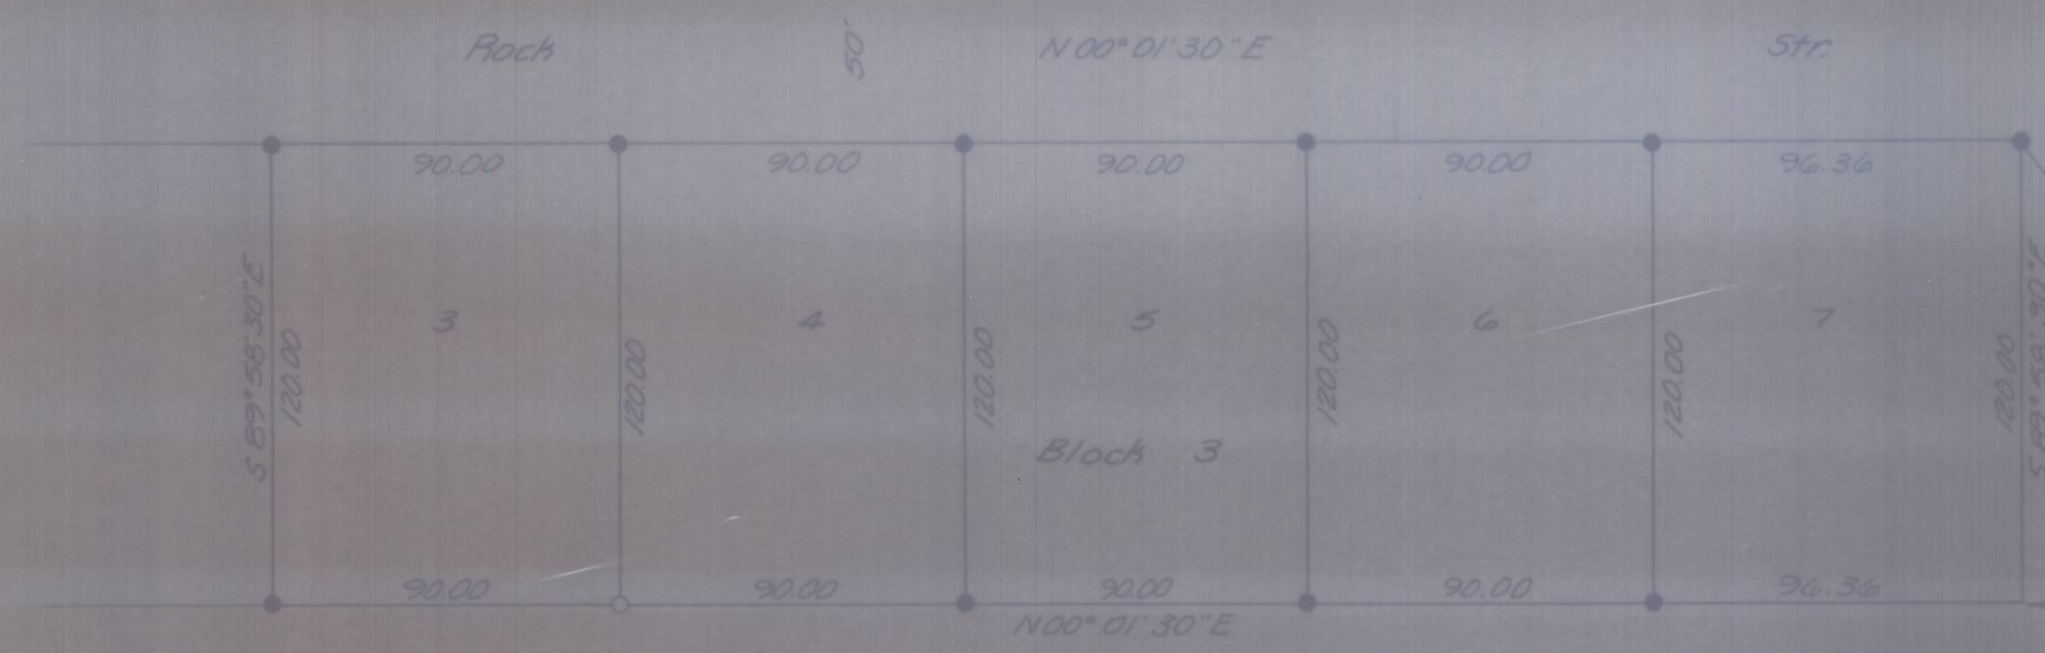


REGISTERED  
PROFESSIONAL  
LAND SURVEYOR

*James H. Buisman*

OREGON  
JULY 22, 1917  
JAMES H. BUISMANN  
1917



 <b>KRUMBEIN ENGINEERING CO.</b> ENGINEERS - SURVEYORS - PLANNERS 221 S. Main, Pendleton, Oregon	SCALE	1" = 50'
	DATE	11-1-78
	DRN. BY	MM
	CKD. BY	JH
	DRNG. NO.	78-428
Survey for <b>P.A. CHAMBERS &amp; ASSOC.</b> Valley View Estates, Heppner, Oregon		

Job No. 78-244

B-179-K-157

B-179-K