

*Umatilla Electric Coop  
Hermiston, Oregon*

**Property Description:**

Beginning at a point N. 89° 17' 09" E., 30' and N. 00° 58' 40" W., 30' from the Section corner common to Sections 7 and 18, T. 3 N., R. 26 E., W.M., and Sections 12 and 13, T. 3 N., R. 25 E., W.M.; thence N. 89° 17' 09" E., 150'; thence N. 00° 58' 40" W., 170'; thence S. 89° 17' 09" W., 150'; thence S. 00° 58' 40" E., 170' to the point of beginning.


Located in the SW 1/4 of the SW 1/4 of Section 7, T. 3 N., R. 26 E., W.M., Morrow County, Oregon.

Contains 0.58 acre more or less.

**Certificate of Survey:**

I, Robert Welty, Registered Engineer Certificate #2368 of the State of Oregon do hereby certify that the accompanying described plat represents a true survey to the best of my knowledge and belief

Date: November 16, 1973.

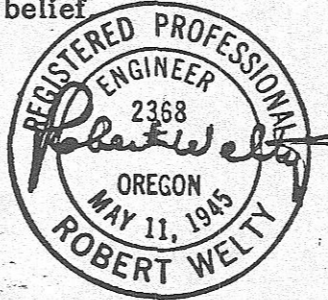

*47-11-1  
John James  
Robert Welty*

UMATILLA ELECTRIC COOP, ASS'N.  
HERMISTON, OREGON  
OREGON 14 UMATILLA  
HOMESTEAD  
SUBSTATION SITE SURVEY

ROBERT WELTY ENGINEERS, INC. THE DALLES, OREGON  
OWN. BY: L.B. DATE: 11/19/73 SCALE: 1"=100' SUR. BY: A.W.

B-205-K-172

B-# 205-K