


• denotes 40' x 100' set

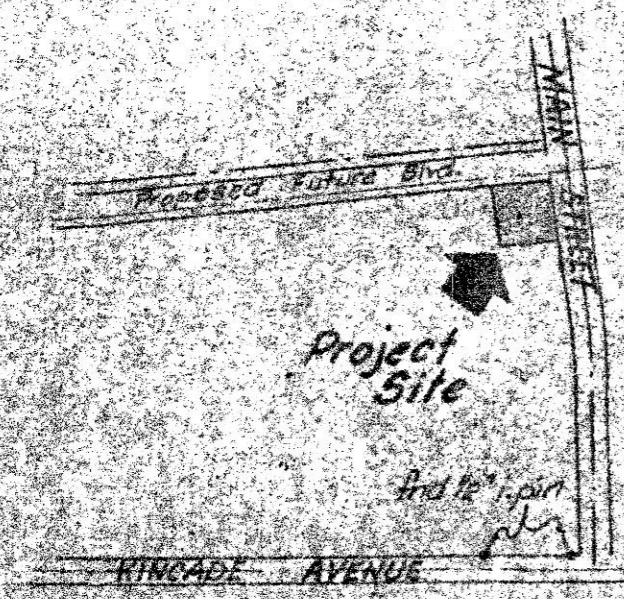

Site Map

See Edward's Survey drawing in Morrow county - #153-K in reference to found pits.

RECEIVED BY
 Morrow County Surveyor
 Date 11-15-79
 Rec'd By ymjs
 No. # 261-K

K KRUMBEIN ENGINEERING CO
 ENGINEERS - SURVEYORS - PLANNERS
 221 S. Main, Pendleton, Oregon

Survey for
CIRCLE K SITE

NW 1/4 Sec 16, T44N, R25E boardman Ore

SCALE	1" = 50'
DATE	10-29-79
DWN BY	ymjs
CKD BY	ymjs
DRG. NO.	261-K