


T 5 N R 27 E

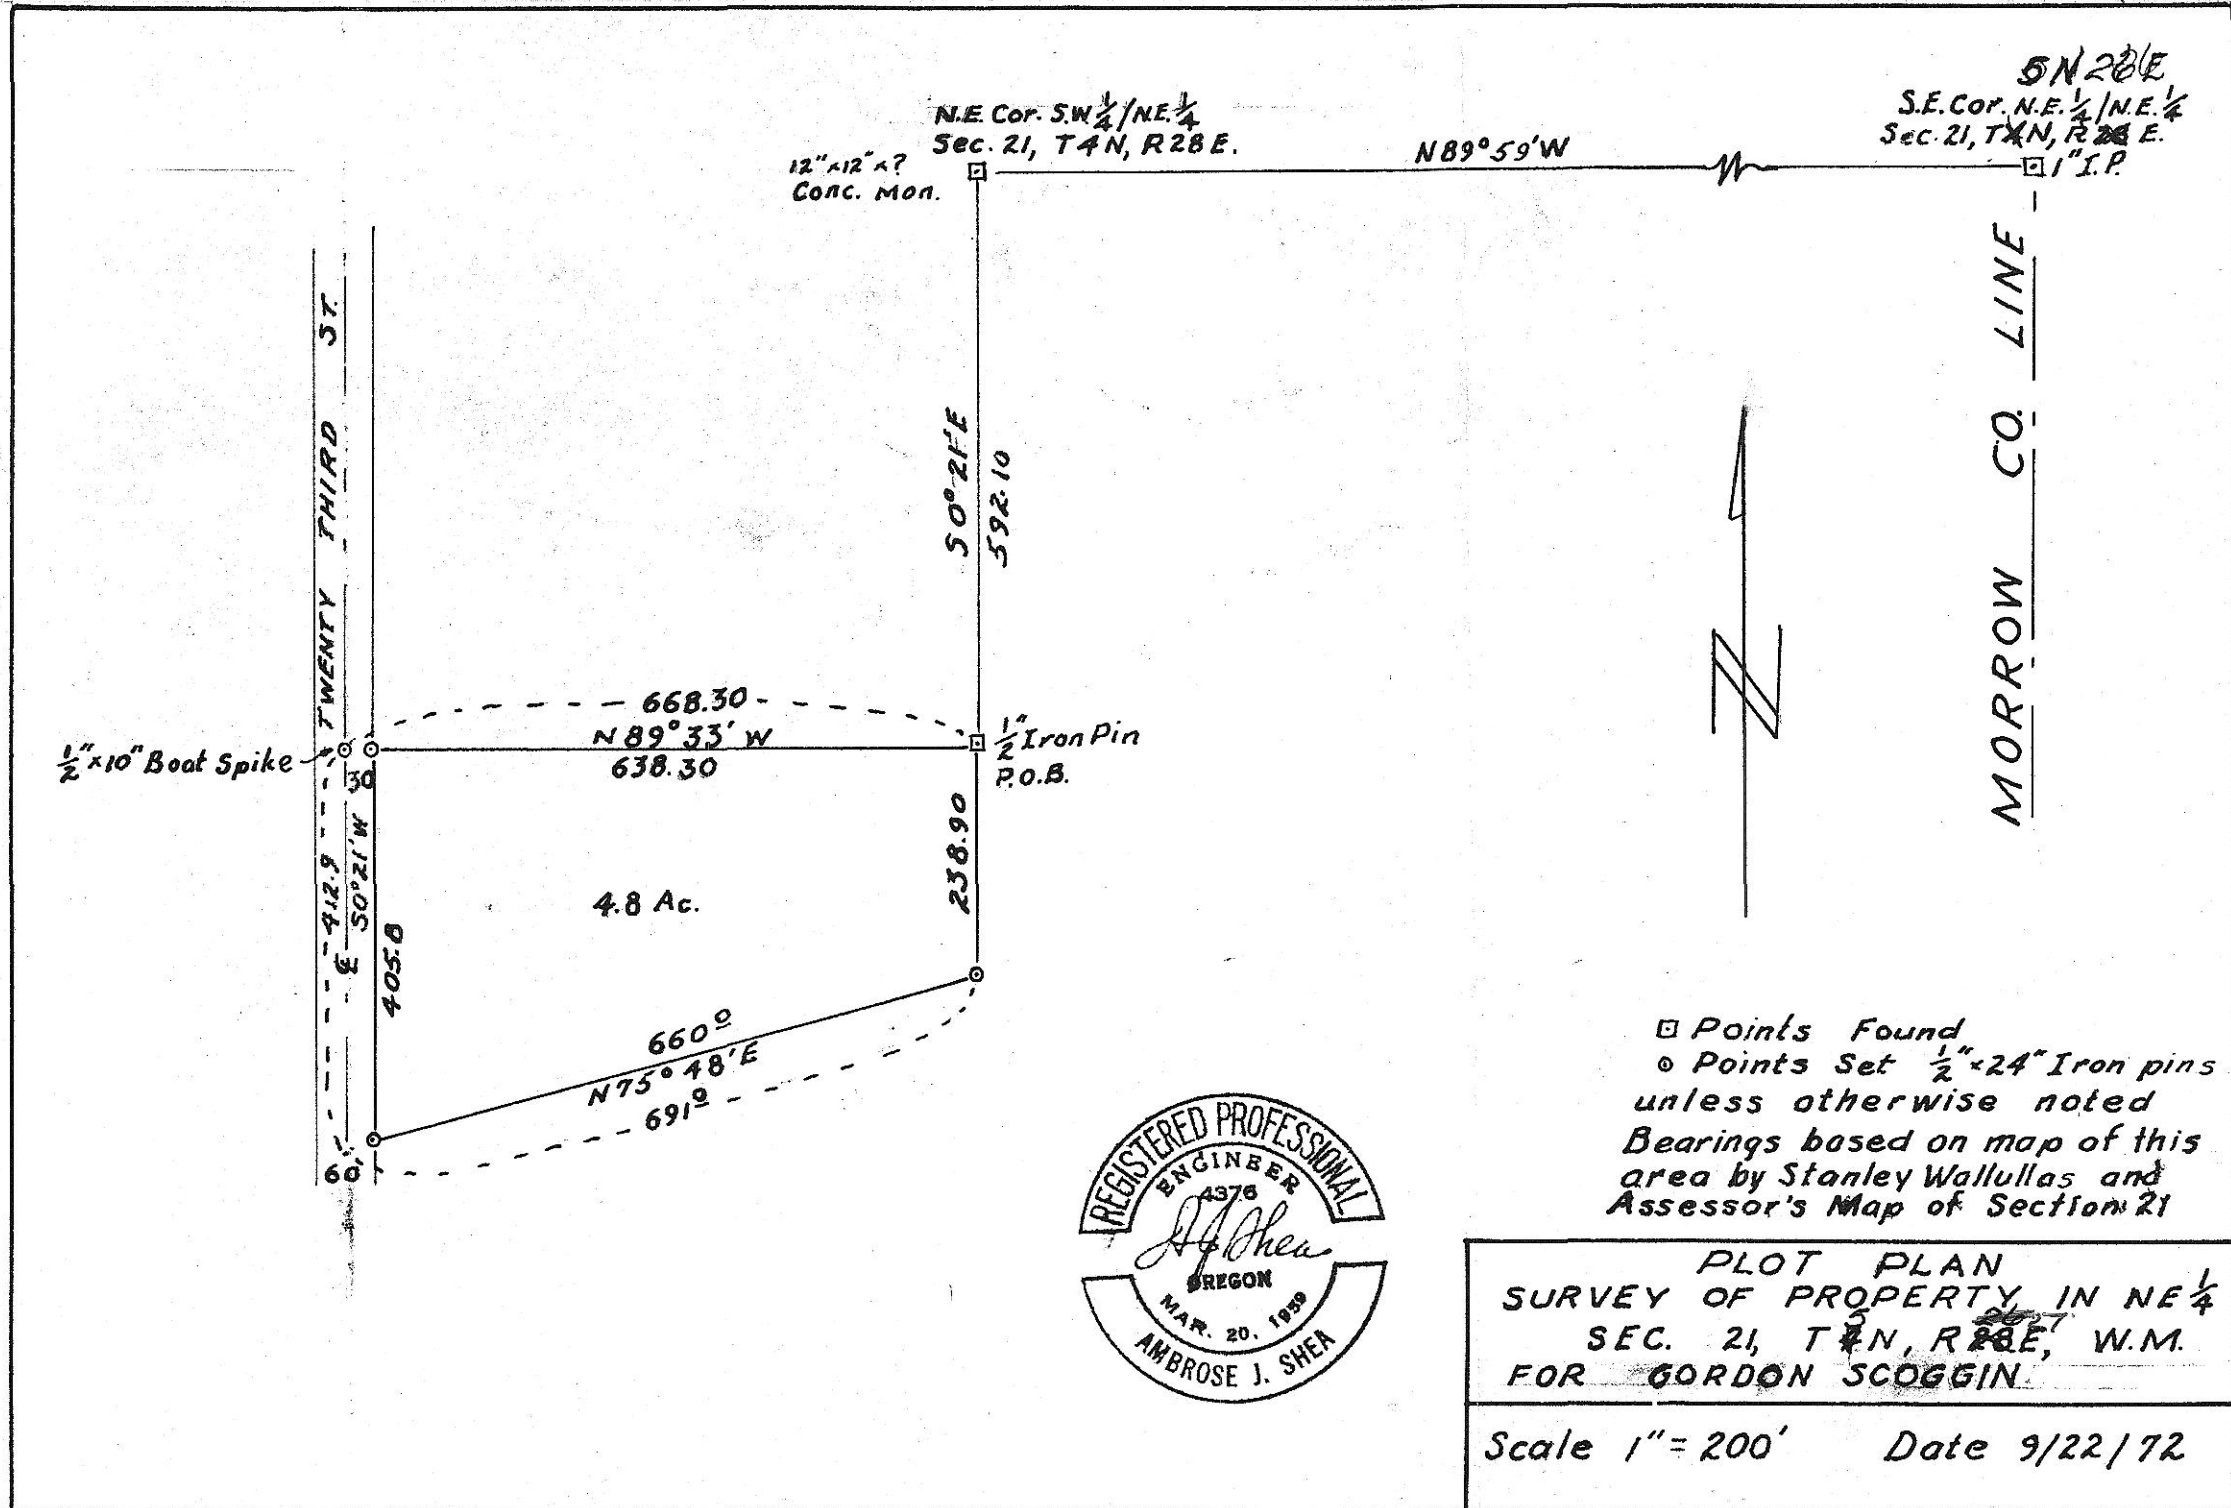

□ Points Found
 ○ Points Set $\frac{1}{2}$ " \times 24" Iron pins
 unless otherwise noted
 Bearings based on map of this
 area by Stanley Wallulas and
 Assessor's Map of Section 21

PLOT PLAN
 SURVEY OF PROPERTY IN NE $\frac{1}{4}$
 SEC. 21, T 5 N, R 28 E, W.M.
 FOR GORDON SCOGGIN

Scale 1" = 200' Date 9/22/72

B-283-K-188

B # 283-K