


o denotes monument found

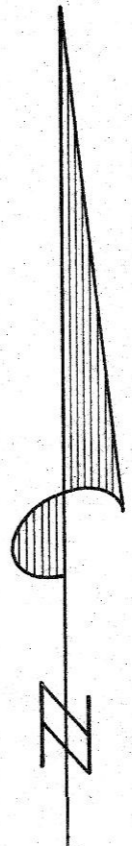

REGISTERED
PROFESSIONAL
LAND SURVEYOR
David H. Krumbein
OREGON
JULY 17, 1976
DAVID H. KRUMBEIN
933

RECEIVED BY
MORROW County Surveyor
Date 5-12-80
Rec'd By *ymj*
No. #299-K

K KRUMBEIN ENGINEERING CO. ENGINEERS - SURVEYORS - PLANNERS 221 S. Main, Pendleton, Oregon	SCALE 1" = 40'
	DATE April 23, 1979
	DRN BY MH
	CKD BY GFB
Survey for HOWARD SALMON	
Lot 1, Blk 1, "Faler Addition," Boardman, Oregon	
DRNG. NO. 79-8B	