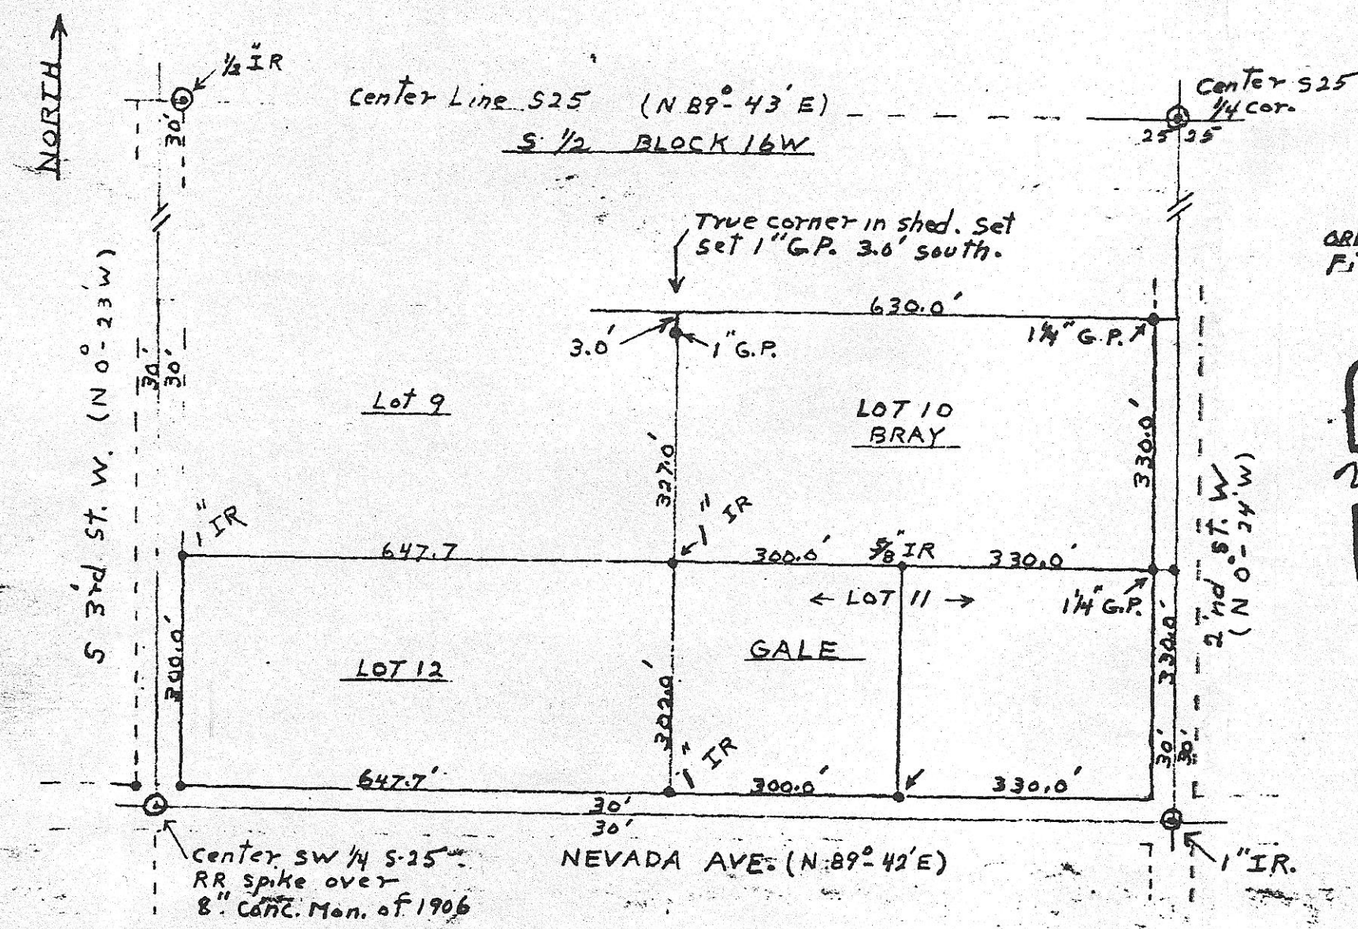

Survey FOR BRAY + GALE
NE 1/4 of SW 1/4 Sect 25, T5N, R26E.
Lots 10, 11 + 12 Block 16W
ORE. L+W Co. SUB. SECT 25 of 1906
Filed 5-24-35

REGISTERED PROFESSIONAL LAND SURVEYOR
W. W. Cramer
OREGON
SEPT. 30, 1977
WALTER W. CRAMER
1423
8-5-80

⊙ Corners Found (15 1/2 Block 16W) = NE 1/4 of SW 1/4 of S-25
Refer Survey of 7-26-80 WWC PLS 1423
• Corners set as indicated
Bearings Base = "Irrigon subdivision (Sect. 25)" Filed 5-24-35

B-384-K-197

RECEIVED BY
Morrow County Surveyor
Date 9-18-80
Rec'd By [illegible]
No. B# 384-K