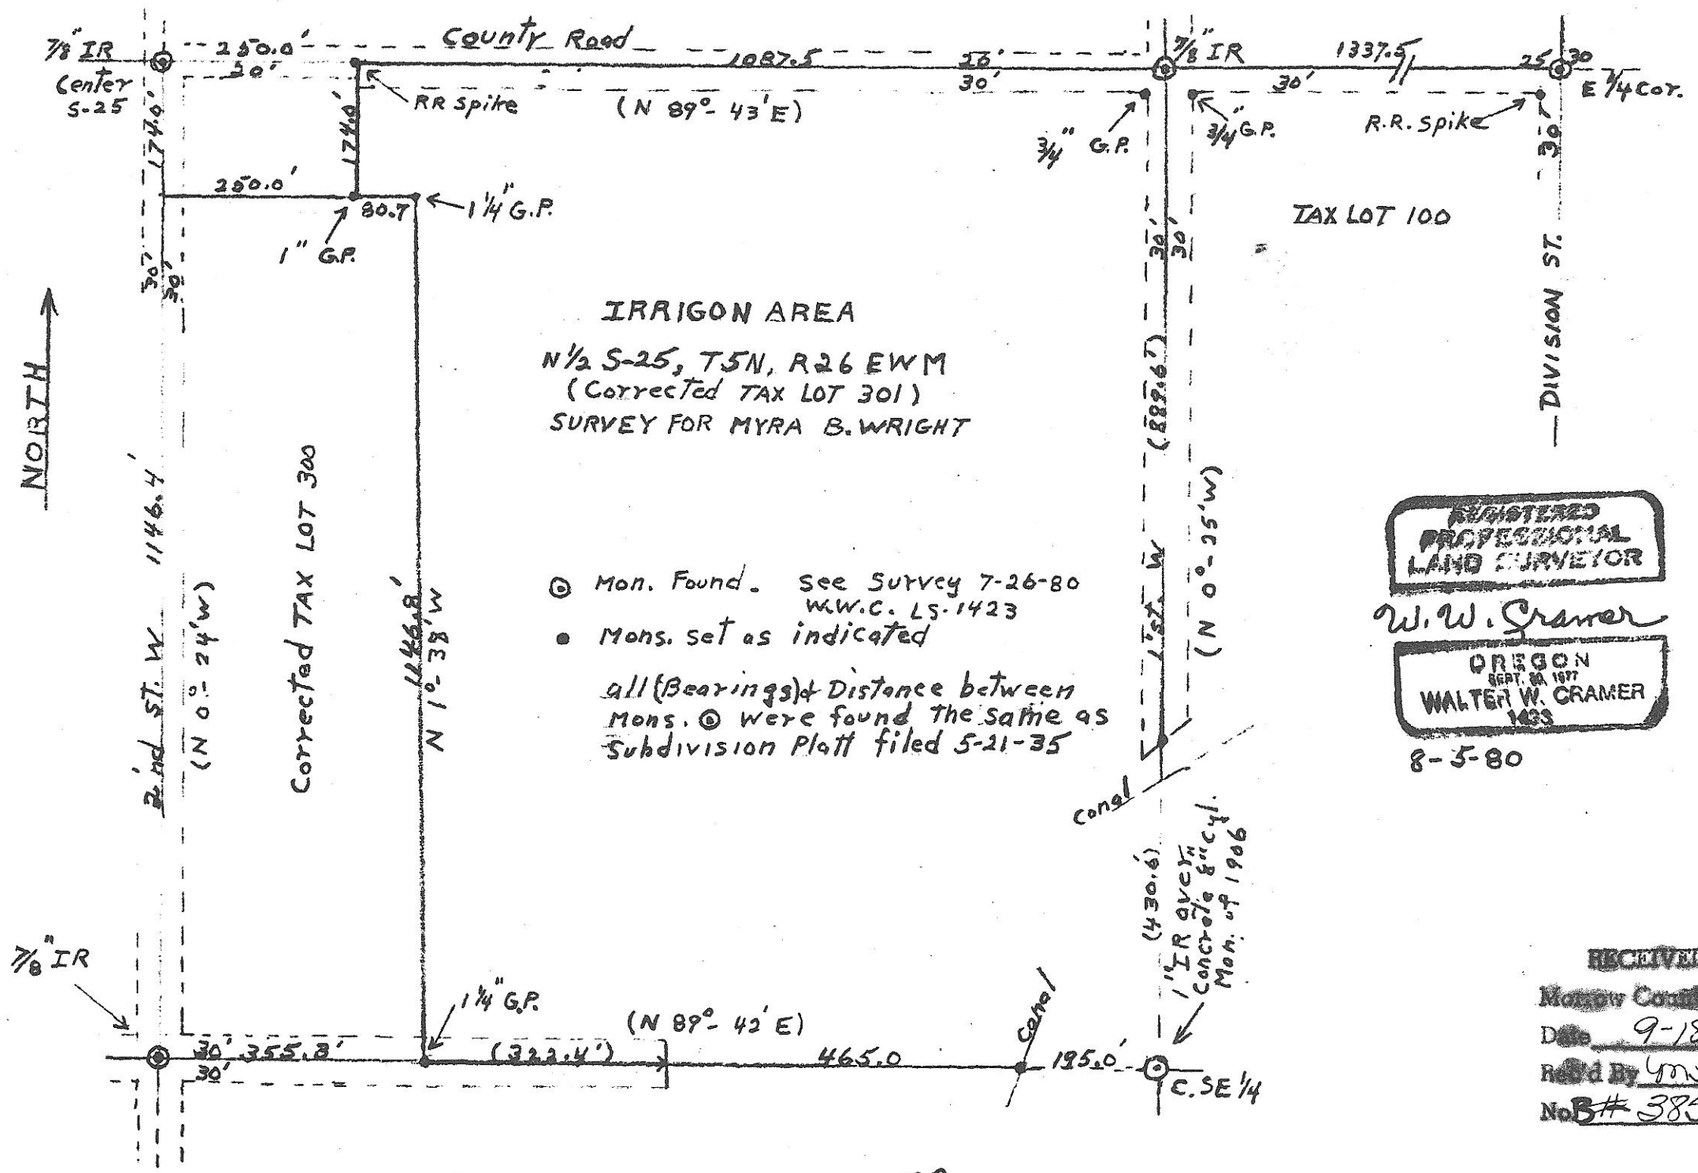

REGISTERED PROFESSIONAL LAND SURVEYOR

W. W. Cramer

OREGON
SEPT. 28, 1977
WALTER W. CRAMER
1423

8-5-80

RECEIVED BY
Morrow County Surveyor
Date 9-18-80
Rec'd By MMS
No B# 385-K

B-385-K-198