


BEARINGS & SURVEY ARE BASED UPON SECTION BREAKDOWN BY EDWARDS FOR SMITH & REED IN 1980.

RECEIVED BY  
 Morrow County Surveyor  
 Date July 23, 1981  
 Rec'd By M. Hughes  
 No. B-422-K - 204

REGISTERED  
 PROFESSIONAL  
 LAND SURVEYOR  
*G. Dennis Edwards*  
 OREGON  
 JULY 18, 1971  
 G. DENNIS EDWARDS  
 951

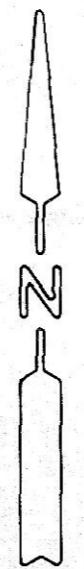

SURVEY FOR: SAM KNAPP

LOCATION: SECTION 30, T5N, R27E, W.M. MORROW CO., OREGON

● MONUMENTS FOUND  
 ○ MONUMENTS SET  
 DATE: 3-1-81 JOB NO. 8012250  
 SCALE: 1" = 300'

EDWARDS SURVEYING  
 P.O. BOX 763 HERMISTON, OREGON 567-3336