


OREGON AVE.

THIRD ST.

FOURTH ST.

N. MAIN AVE.

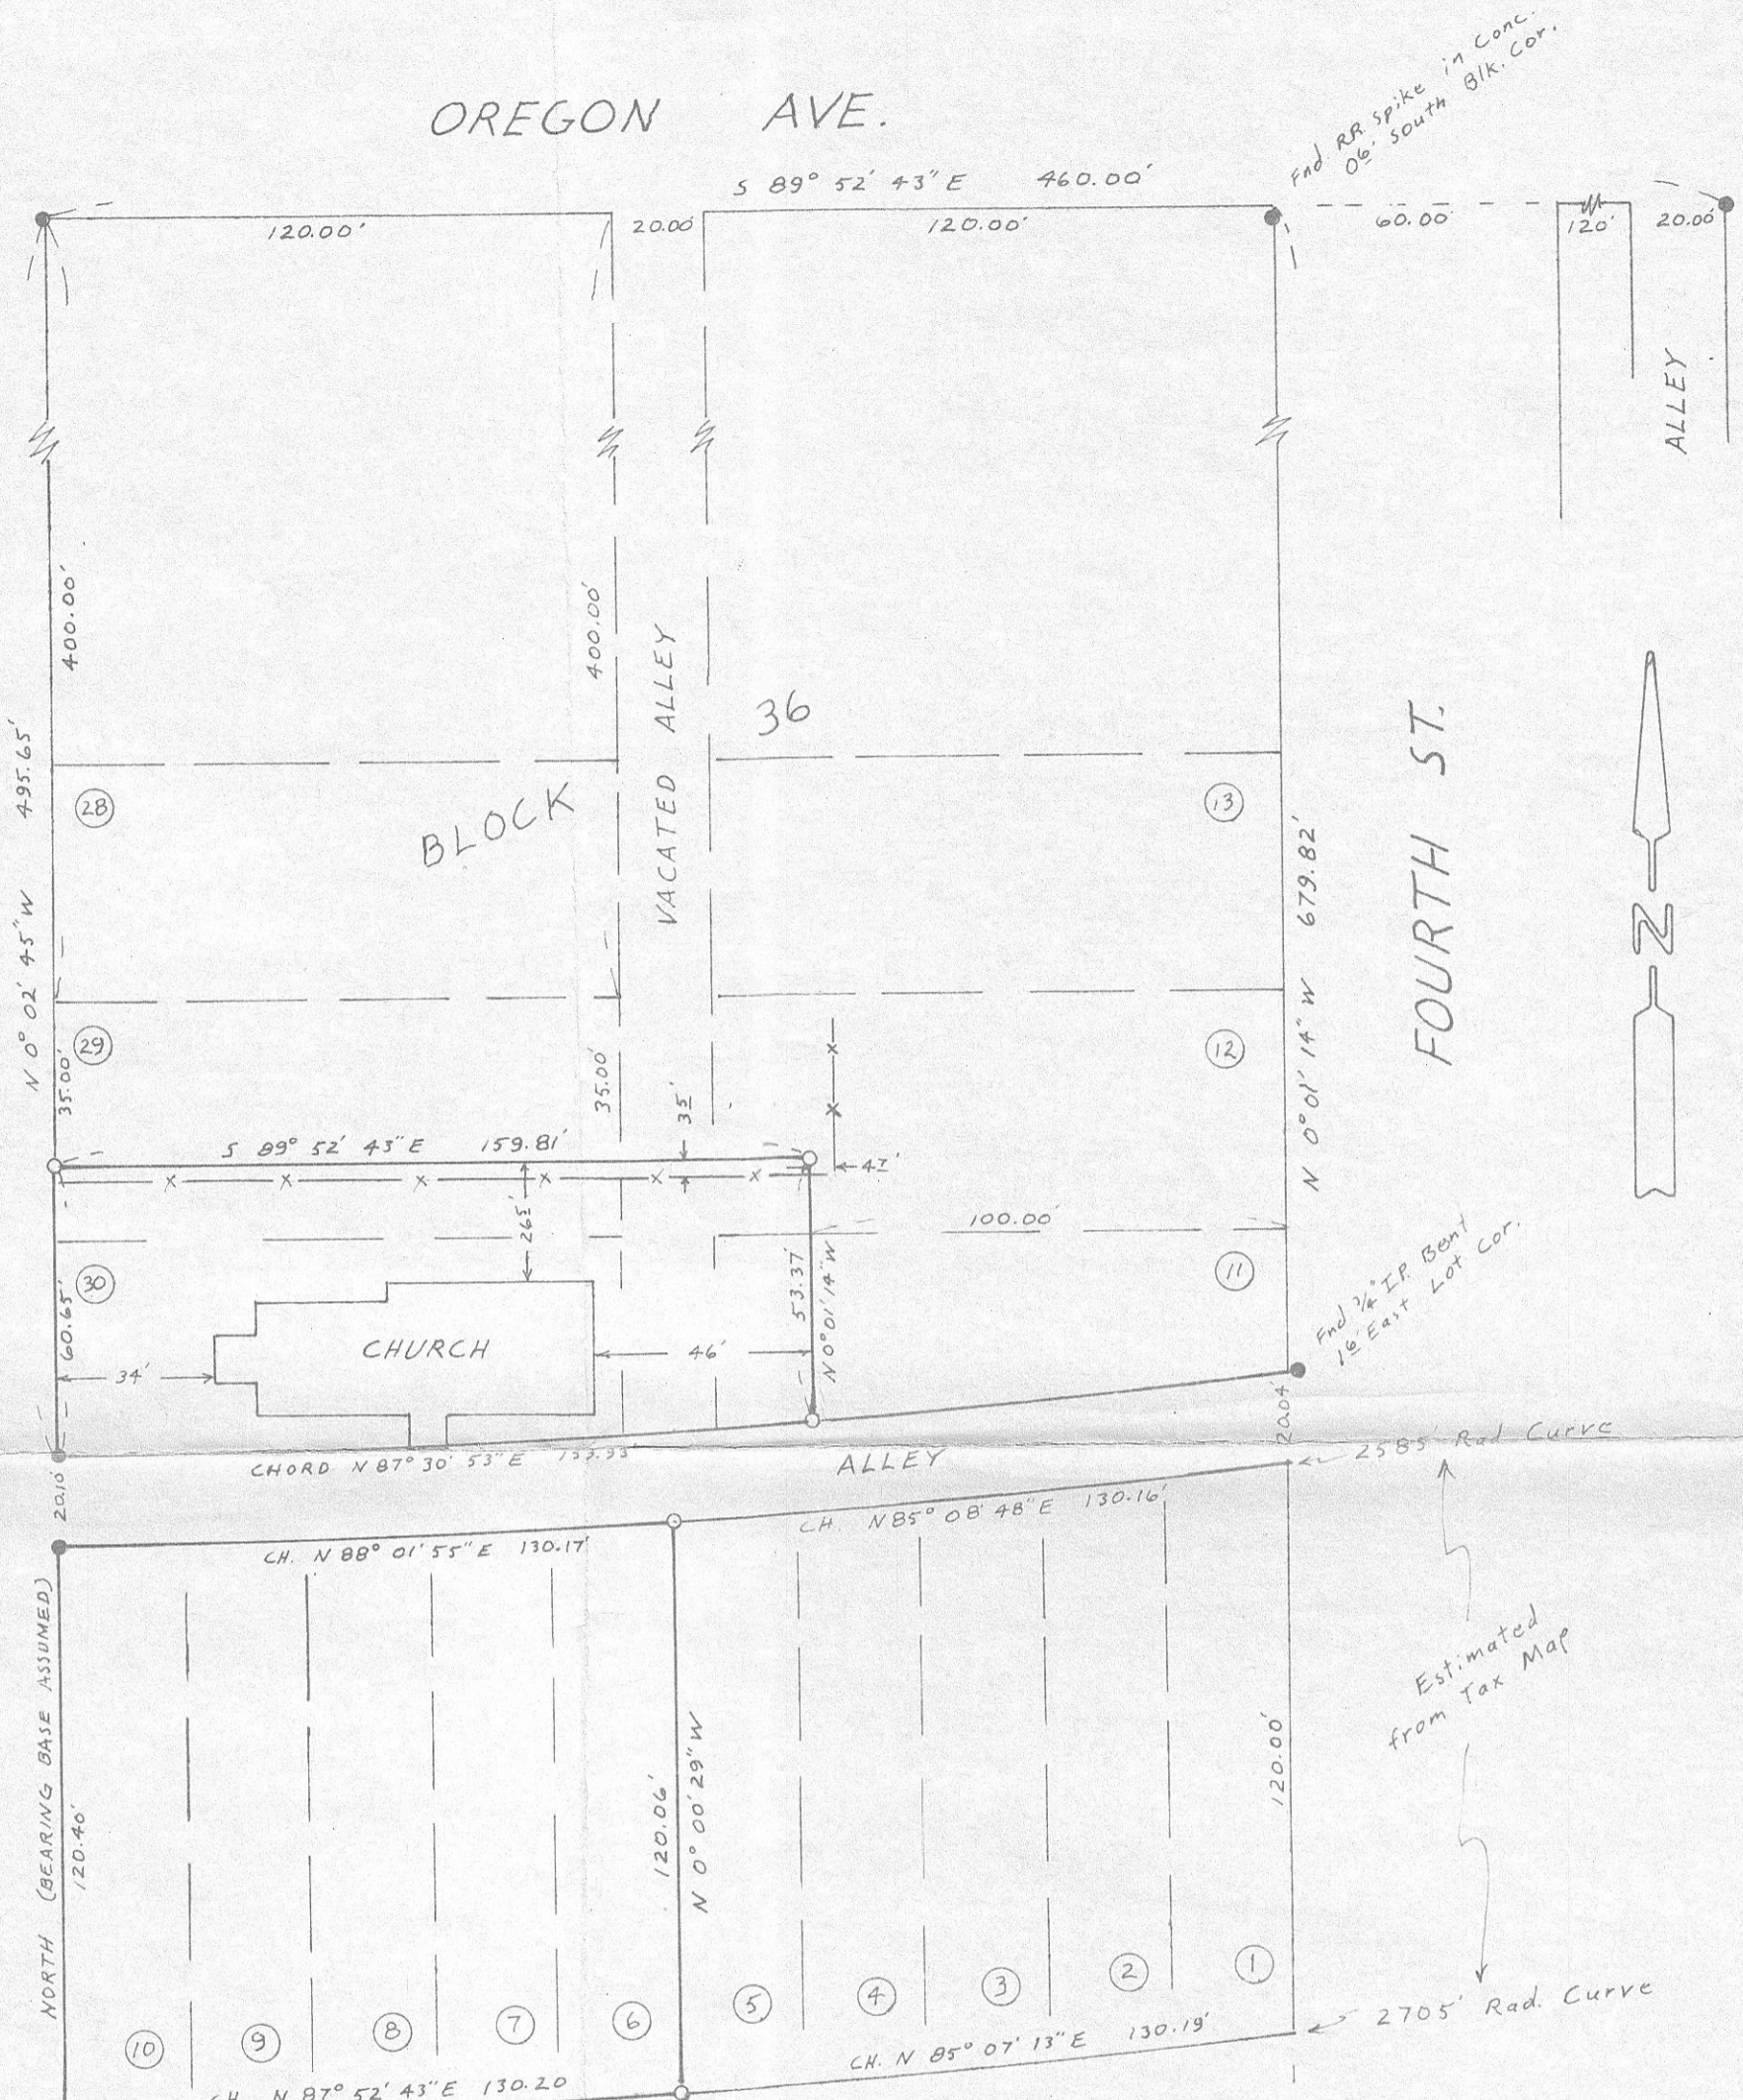

RECEIVED BY  
 Morrow County Surveyor  
 Date April 13, 1982  
 Rec'd By M. Hughes  
 No. B-498-K-217

SURVEY FOR 7<sup>th</sup>-Day ADVENTIST CHURCH  
 LOCATION SE 1/4 (BLK 36 City of Irrigon)  
 SEC 24, T 5 N, R 26 E, W 1/2, MORROW COUNTY, OREGON  
 DATE 3/1/82  
 SCALE 1" = 40'  
 ● 1/2" IRON MONUMENTS  
 ○ 1/2" IRON RODS SET  
 1000' OF RECORD  
 100' NO. 58202004  
 EDWARDS SURVEYING  
 587-3336  
 P. O. Box 763  
 Hermiston, Ore

REGISTERED  
 PROFESSIONAL  
 LAND SURVEYOR  
*D. Dennis Edwards*  
 OREGON  
 JULY 18, 1971  
 G. DENNIS EDWARDS  
 951

B-498-K-2