


NARRATIVE

The purpose of this survey was to establish the boundaries as noted by Deed. The Deed calls for the East 400.00 feet of the NE 1/4, SE 1/4 of Section 24, lying South of the West Extension Irrigation Canal and North of a line 554.58 feet North of the SE corner of said NE 1/4, SE 1/4. At this point the West Extension Irrigation Canal has a 100 foot right-of-way on each side of the canal.


Bearing are based on a survey by McConnell Land Surveying for Fred Johnson and Chester Stewart dated October 26, 1976, Morrow County Survey Records drawing no. C-59-K.

- denotes 1/2 in. iron pin with plastic cap marked McConnell PLS 859 found
- denotes monument found as noted
- denotes 3/8 in. x 30 in. iron pin with aluminum cap set
- () denotes bearing or distance of record

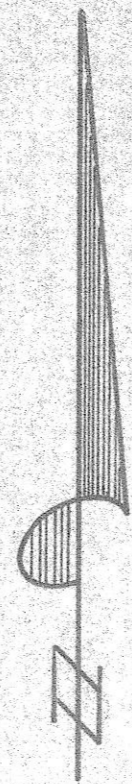

RECEIVED BY
 Morrow County Surveyor
 Date June 24, 1982
 Rec'd By M. Hughes
 No. B-504-K

Revised Nov. 30, 1982 - MH
 Revised November 5, 1982 - MH

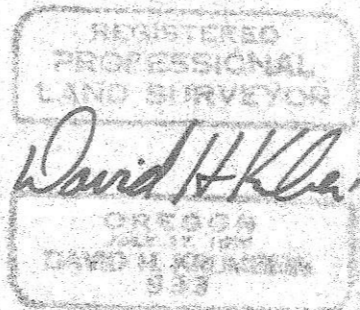

K KRUMBEIN ENGINEERING CO.
 ENGINEERS - SURVEYORS - PLANNERS
 221 S. Main, Pendleton, Oregon

Survey for
CONAWAY

located in NE 1/4, SE 1/4, Section 24, T4N, R24E, W1W.

SCALE 1" = 100'
DATE Jan. 27, 1982
DRN. BY R.D.R.
CKD BY D.H.K.
DRNG. NO. 82-02B