

Ind. 1/2" i. pin
 pin found & used by
 Edwards Engineering
 service on a survey for
 Elmer Ladd dated Sept.
 1979, Morrow County
 Survey Records drawing
 no. C-254-K
 9/10


NARRATIVE

The purpose of this survey was to establish the North line of a parcel belonging to Ken Mooney. We used the points shown on Main Street and distances off the Plat of "Will's Addition" to locate the center of "A" Street. 90 degrees was used because that is what is called for on the "Sperry's Addition" Plats to locate.

No bearings are shown as everything was 90 degrees relative.

Elevation is based upon U665 station 687

- denotes monument found, as noted
- denotes 3/16 in. x 30 in. iron pin with aluminum cap set
- denotes PK nail set

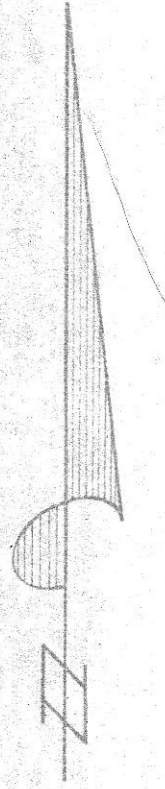

RECEIVED BY
 Morrow County Surveyor
 Date June 24, 1982
 Rec'd By M. Hughes
 No. B-505-K

REGISTERED
 PROFESSIONAL
 LAND SURVEYOR
 David H. Klein
 David H. Klein

K KRUMBEIN ENGINEERING CO
 ENGINEERS - SURVEYORS - PLANNERS
 221 S. Main, Pendleton, Oregon
 Survey for
KEN MOONEY
 NW1/4, NE1/4, Section 9, T15, R24E, W1M, 107E, Oregon

SCALE 1" = 50'
DATE MAY 23, 1982
DRN. BY MH
CKD BY DJK
DRNG. NO. 82 0518