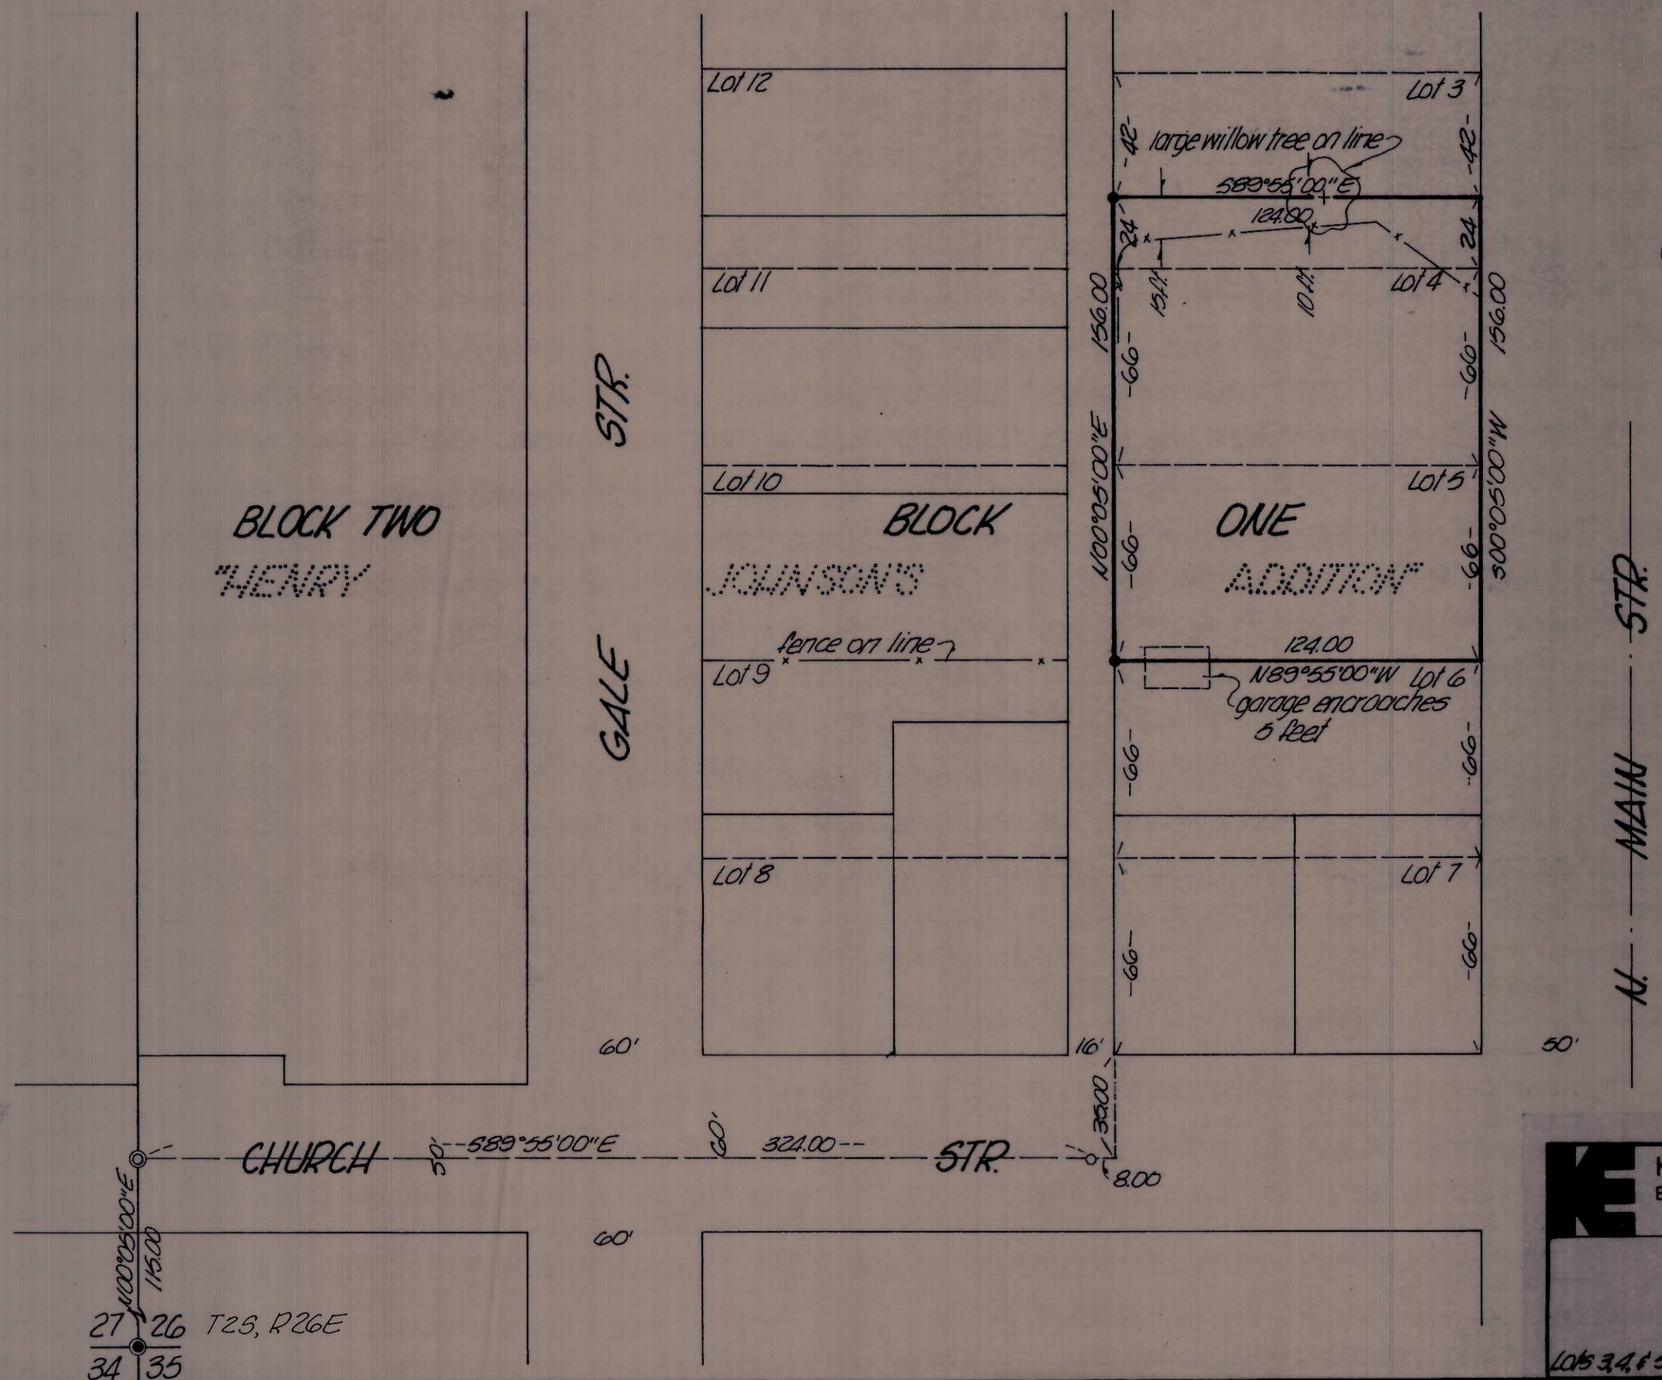

- ◉ denotes wagon axle found
- ◎ denotes Brass Cap Witness Corner found as set in 1980 by Morrow Co. Surveyor, David H. Krumbein
- • denotes 5/8in. x 30in. iron pin with aluminum cap set
- ○ denotes P.K. nail set

The purpose of this survey was to establish the North and West lines of that tract belonging to Terrel Benge as recorded on Page 280 in Book 51 of the Deed Records of Morrow County, Ore.

The Plat of "Henry Johnson's Additon" to the City of Heppner was used for angles and distances. Bearings are based upon a survey for Morrow County by Krumbein Engineering, Ltd, dated April 11, 1980, Morrow County Survey Records drawing no. C-289-K and a survey for Del Piper by Krumbein Engineering, Co., dated November 1, 1977, Morrow County Survey Records drawing no. C-146-K.

REGISTERED PROFESSIONAL LAND SURVEYOR
David H Krumbein
OREGON
JULY 17, 1970
DAVID H. KRUMBEIN
9 3

RECEIVED BY
Morrow County Surveyor
Date June 24, 1982
Rec'd By M. Hughes
No. B-507-K

KRUMBEIN ENGINEERING CO.
ENGINEERS – SURVEYORS – PLANNERS
221 S. Main, Pendleton, Oregon

Survey for
TERREL BENGE

Lots 3, 4, & 5, Blk 1, "Henry Johnson's Add'n," Heppner, Ore.

SCALE	1"=50'
DATE	May 3, 1982
DRN. BY	MH
CKD BY	D.H.K.
DRNG. NO.	82-15B

B-507-K-222

Job No. 82-57