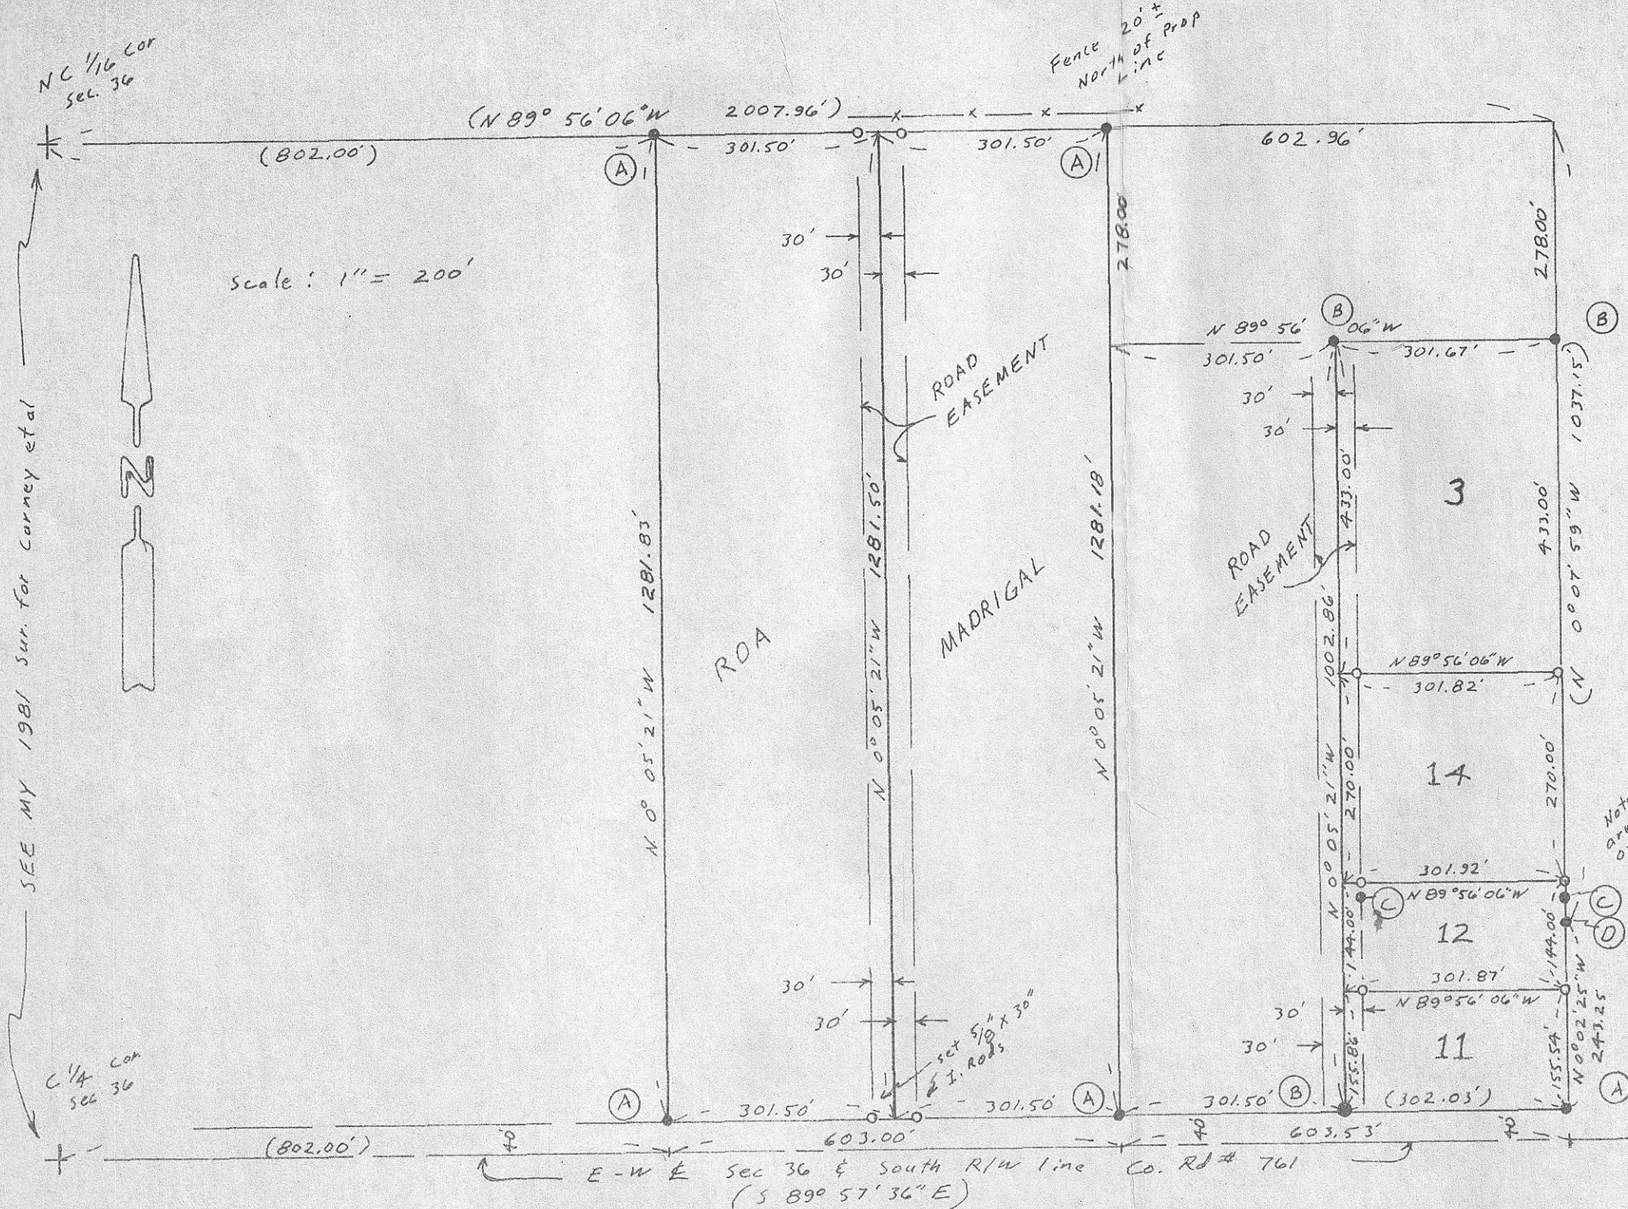

NARRATIVE: The purpose of this survey is to partition some previously surveyed parcels into smaller parcels & to adjust the line between parcels 12 & 14. Bearings are based on on my 1981 survey for Carney et al in which I surveyed these parcels.

It was previously thought that the ℄ of CoRd # 761 was coincident with the E-W ℄ of Sec. 36, but it has been discovered that the entire 40' R/W lies North of said E-W ℄ as it was surveyed in 1919 By Kirschner.

REFERENCES

- (A) 5/8" Iron Rods set in my 1981 sur. for Carney
- (B) 5/8" I. Rods set in LaGier's 1982 sur for John Shafer.
- (C) 1/2" I. Rods set in my 1984 sur. for J. Shafer
- (D) 5/8" I. Rod set By Krumbein in 1977 sur for Hahn.
- o 1/2" x 24" I. Rod set with Alum. Tag stamped 951 unless noted as 5/8" I. Rod.

REGISTERED PROFESSIONAL LAND SURVEYOR

G. Dennis Edwards

OREGON
JULY 19, 1971
G. DENNIS EDWARDS
951

RECEIVED BY
Morrow County Surveyo
Date 8/13/85
Rec'd By MLD
No. 8-713-K

SURVEY FOR. J. SHAFER, A. MADRIGAL, F. ROA, & T. COLEMAN
IN NE ¼ Sec. 36, T 5 N, R 26 E, W.M., MORROW CO., OREGON
5/3/85 Job # S84 06055-A

EDWARDS SURVEYING
567-3336
P.O. BOX 763
HERMISTON, OR.