


FND. BRASS SCREW  
& WASHER SEE KRUMBEIN  
SURVEY FOR MORROW  
CO. SCHOOLS.

THE PURPOSE OF THIS SURVEY WAS TO SET THE  
PROPERTY CORNERS TO TAX LOT 700. REFERENCE  
SURVEYS USED WERE DAVE KRUMBEIN'S SURVEY FOR  
MORROW COUNTY SCHOOLS DATED 1-21-83, AND MY  
SURVEYS FOR FRAN OWENS DATED 5-27-83, AND FOR  
FRANK AND DORIS HANEY DATED 5-27-87, AND ALSO  
TAMBLYN'S 1935 PLAT. PLAT ANGLES AND DISTANCES  
MATCH CLOSELY TO THE ONES ON HIS PLAT.



- ▲ 5/8"X30" IRON ROD & CAP MKD. LS 1861 SET
- 5/8"X30" IRON ROD & CAP MKD. LS 1861 FND.
- MON. FND. AS NOTED

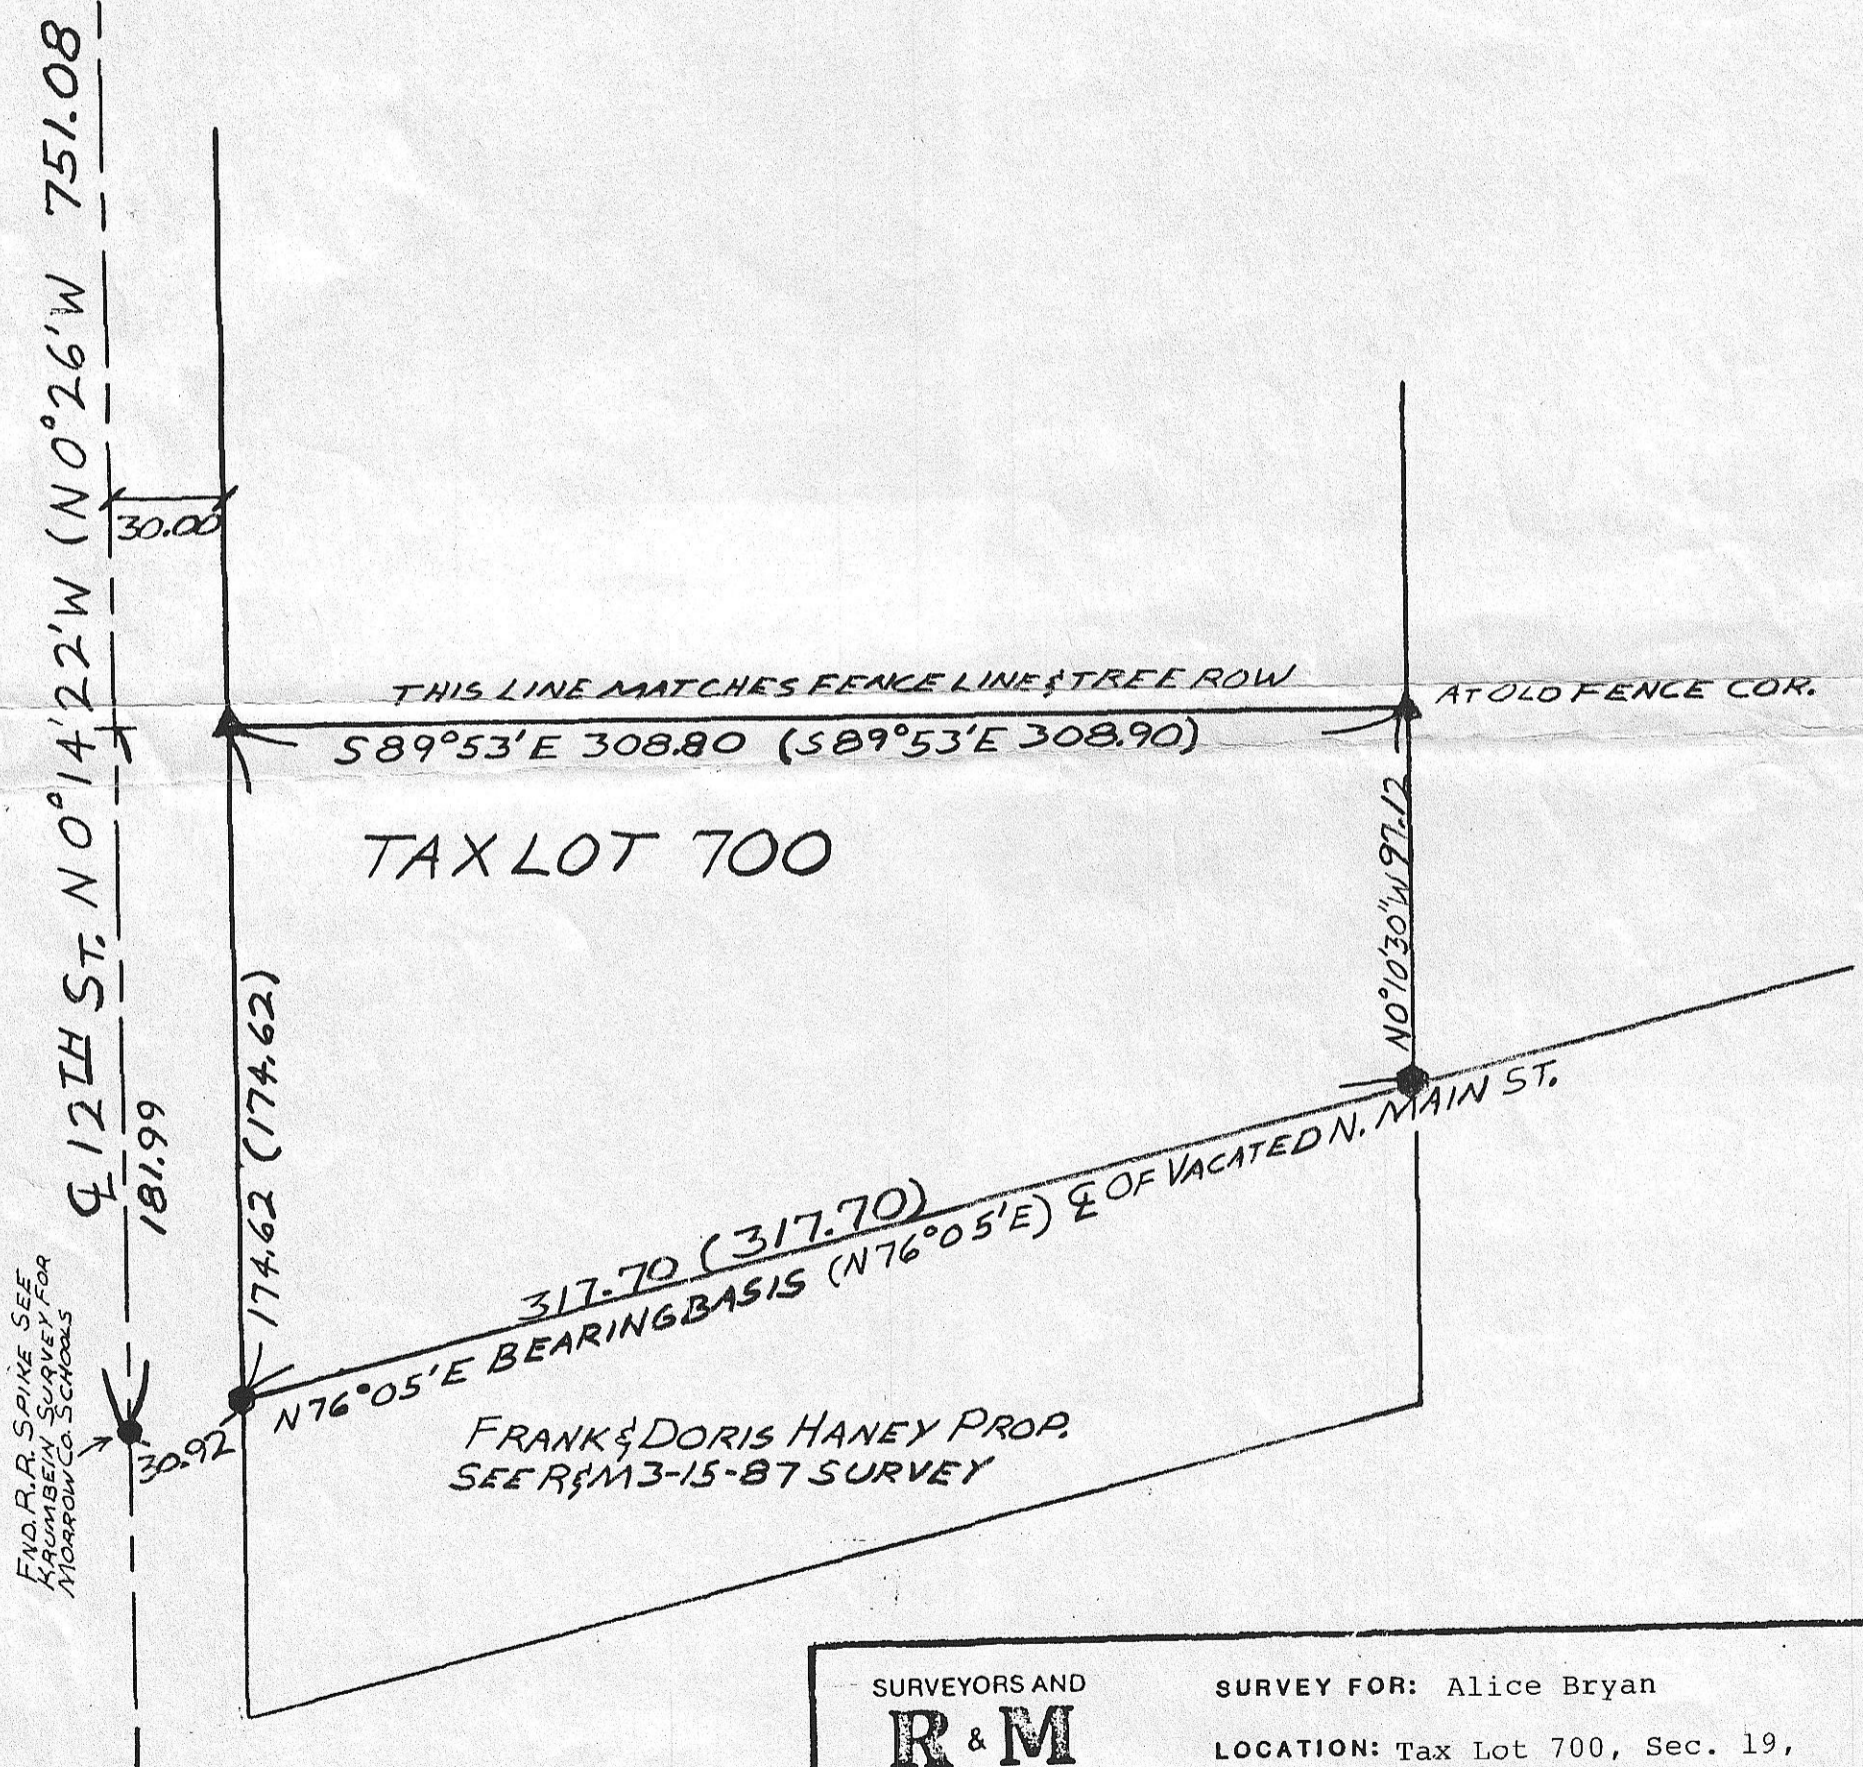

FND. R.R. SPIKE SEE  
KRUMBEIN SURVEY FOR  
MORROW CO. SCHOOLS

SURVEYORS AND <b>R &amp; M</b> CONSULTANTS, INC.	SURVEY FOR: Alice Bryan  LOCATION: Tax Lot 700, Sec. 19, T5N, R.27 EWM, Morrow Co. OR
P.O. BOX 709 IRRIGON, OR. 97844 PH: 922-3093	REGISTERED PROFESSIONAL LAND SURVEYOR  <i>Earl D. Ming</i>
SCALE 1" = 50' DATE 12-28-88 DRWNBY EDM CHKDBY KJM REVISION NO 0 DRWG NO 88-1228-1	
	OREGON DEC. 14, 1979 EARL D. MING 1861
	RECEIVED BY Morrow County Surveyor Date <u>1/89</u> Rec'd By <u>DE</u> No. <u>B 003 E-275</u>