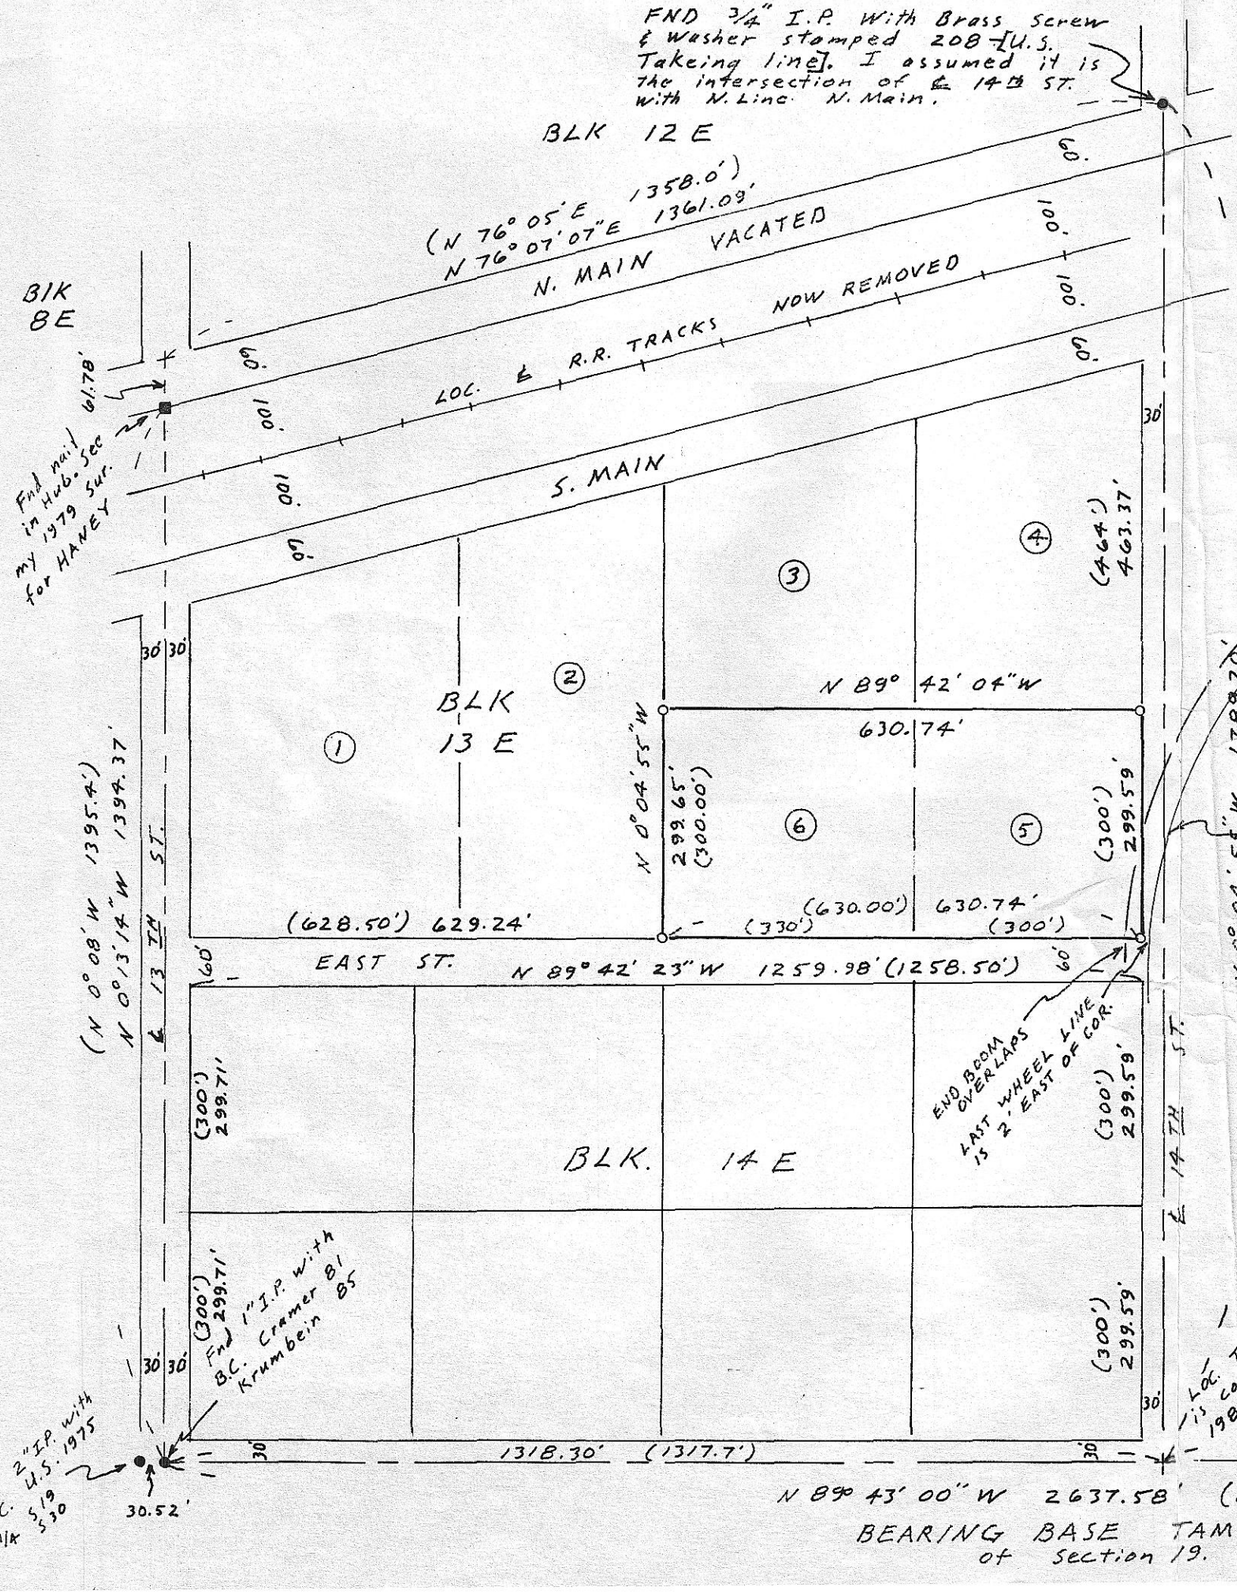

REGISTERED PROFESSIONAL LAND SURVEYOR
G. Dennis Edwards
OREGON
JULY 16, 1971
G. DENNIS EDWARDS
901

SURVEY FOR DON HURD

IN BLK 13 E, SE¼ Sec. 19, T5N, R27E, W.M. MORROW CO., OREGON

10/10/88 Job # 58809032

EDWARDS SURVEYING P.O. Box 763
567-3336 HERMISTON, OREGON

NARRATIVE: The purpose of this survey is to set the corners of lots 5 & 6, Blk 13E, so a fence can be built and to check some corners that Ivan Driver has set in a survey which is still in progress. Driver's Iron Rod with copper cap at the sw cor. lot 6 is approximately 0.3 North & 1.2 East of my corner. His Iron rod at the N.E. cor. Lot 5 is 0.5 N. & 0.1 E. of my corner.

I surveyed to the computed location of the N.E cor. of Blk 11 E (℄ 14TH & Riverside) of Tamblyn's plat and probed a large area 2' deep for a concrete mon. similar to ones found at other locations on Tamblyn's plat. I did not find it. It could be very deep in a sand blow.

I used the U.S. Takeing line monument as the location of the intersection of the ℄ of 14TH ST. with the north line N. Main STREET Because it fits angle & distance measurments reasonably well that are shown on Tamblyn's Plat.

There is a double corner at the ¼ cor S19 S30. For an explanation see my 1980 sur. for Smith et al in sec. 30 or my 1987 sur. for Prouty in Sec. 19.

SCALE: 1" = 200'

- o ½" x 30" Rebar set with alum tag # 951
- ● Monuments Found
- (000) of record Tamblyn's 1935 Plat of Sec. 19

RECEIVED BY
Morrow County Surveyor
Date 1/89
Rec'd By DC
No. B 085 E-277