


BASIS OF BEARING

SOLAR OBSERVATION

S 1/4 CORNER, SECTION 26
OCTOBER 18, 1975
LATITUDE: 45° 00' 37"
DECLINATION: 9° 40' 25.8" S
VERTICAL ANGLE: 7° 00' 15"
MEAN MAGNETIC DECLIN.: 20° E

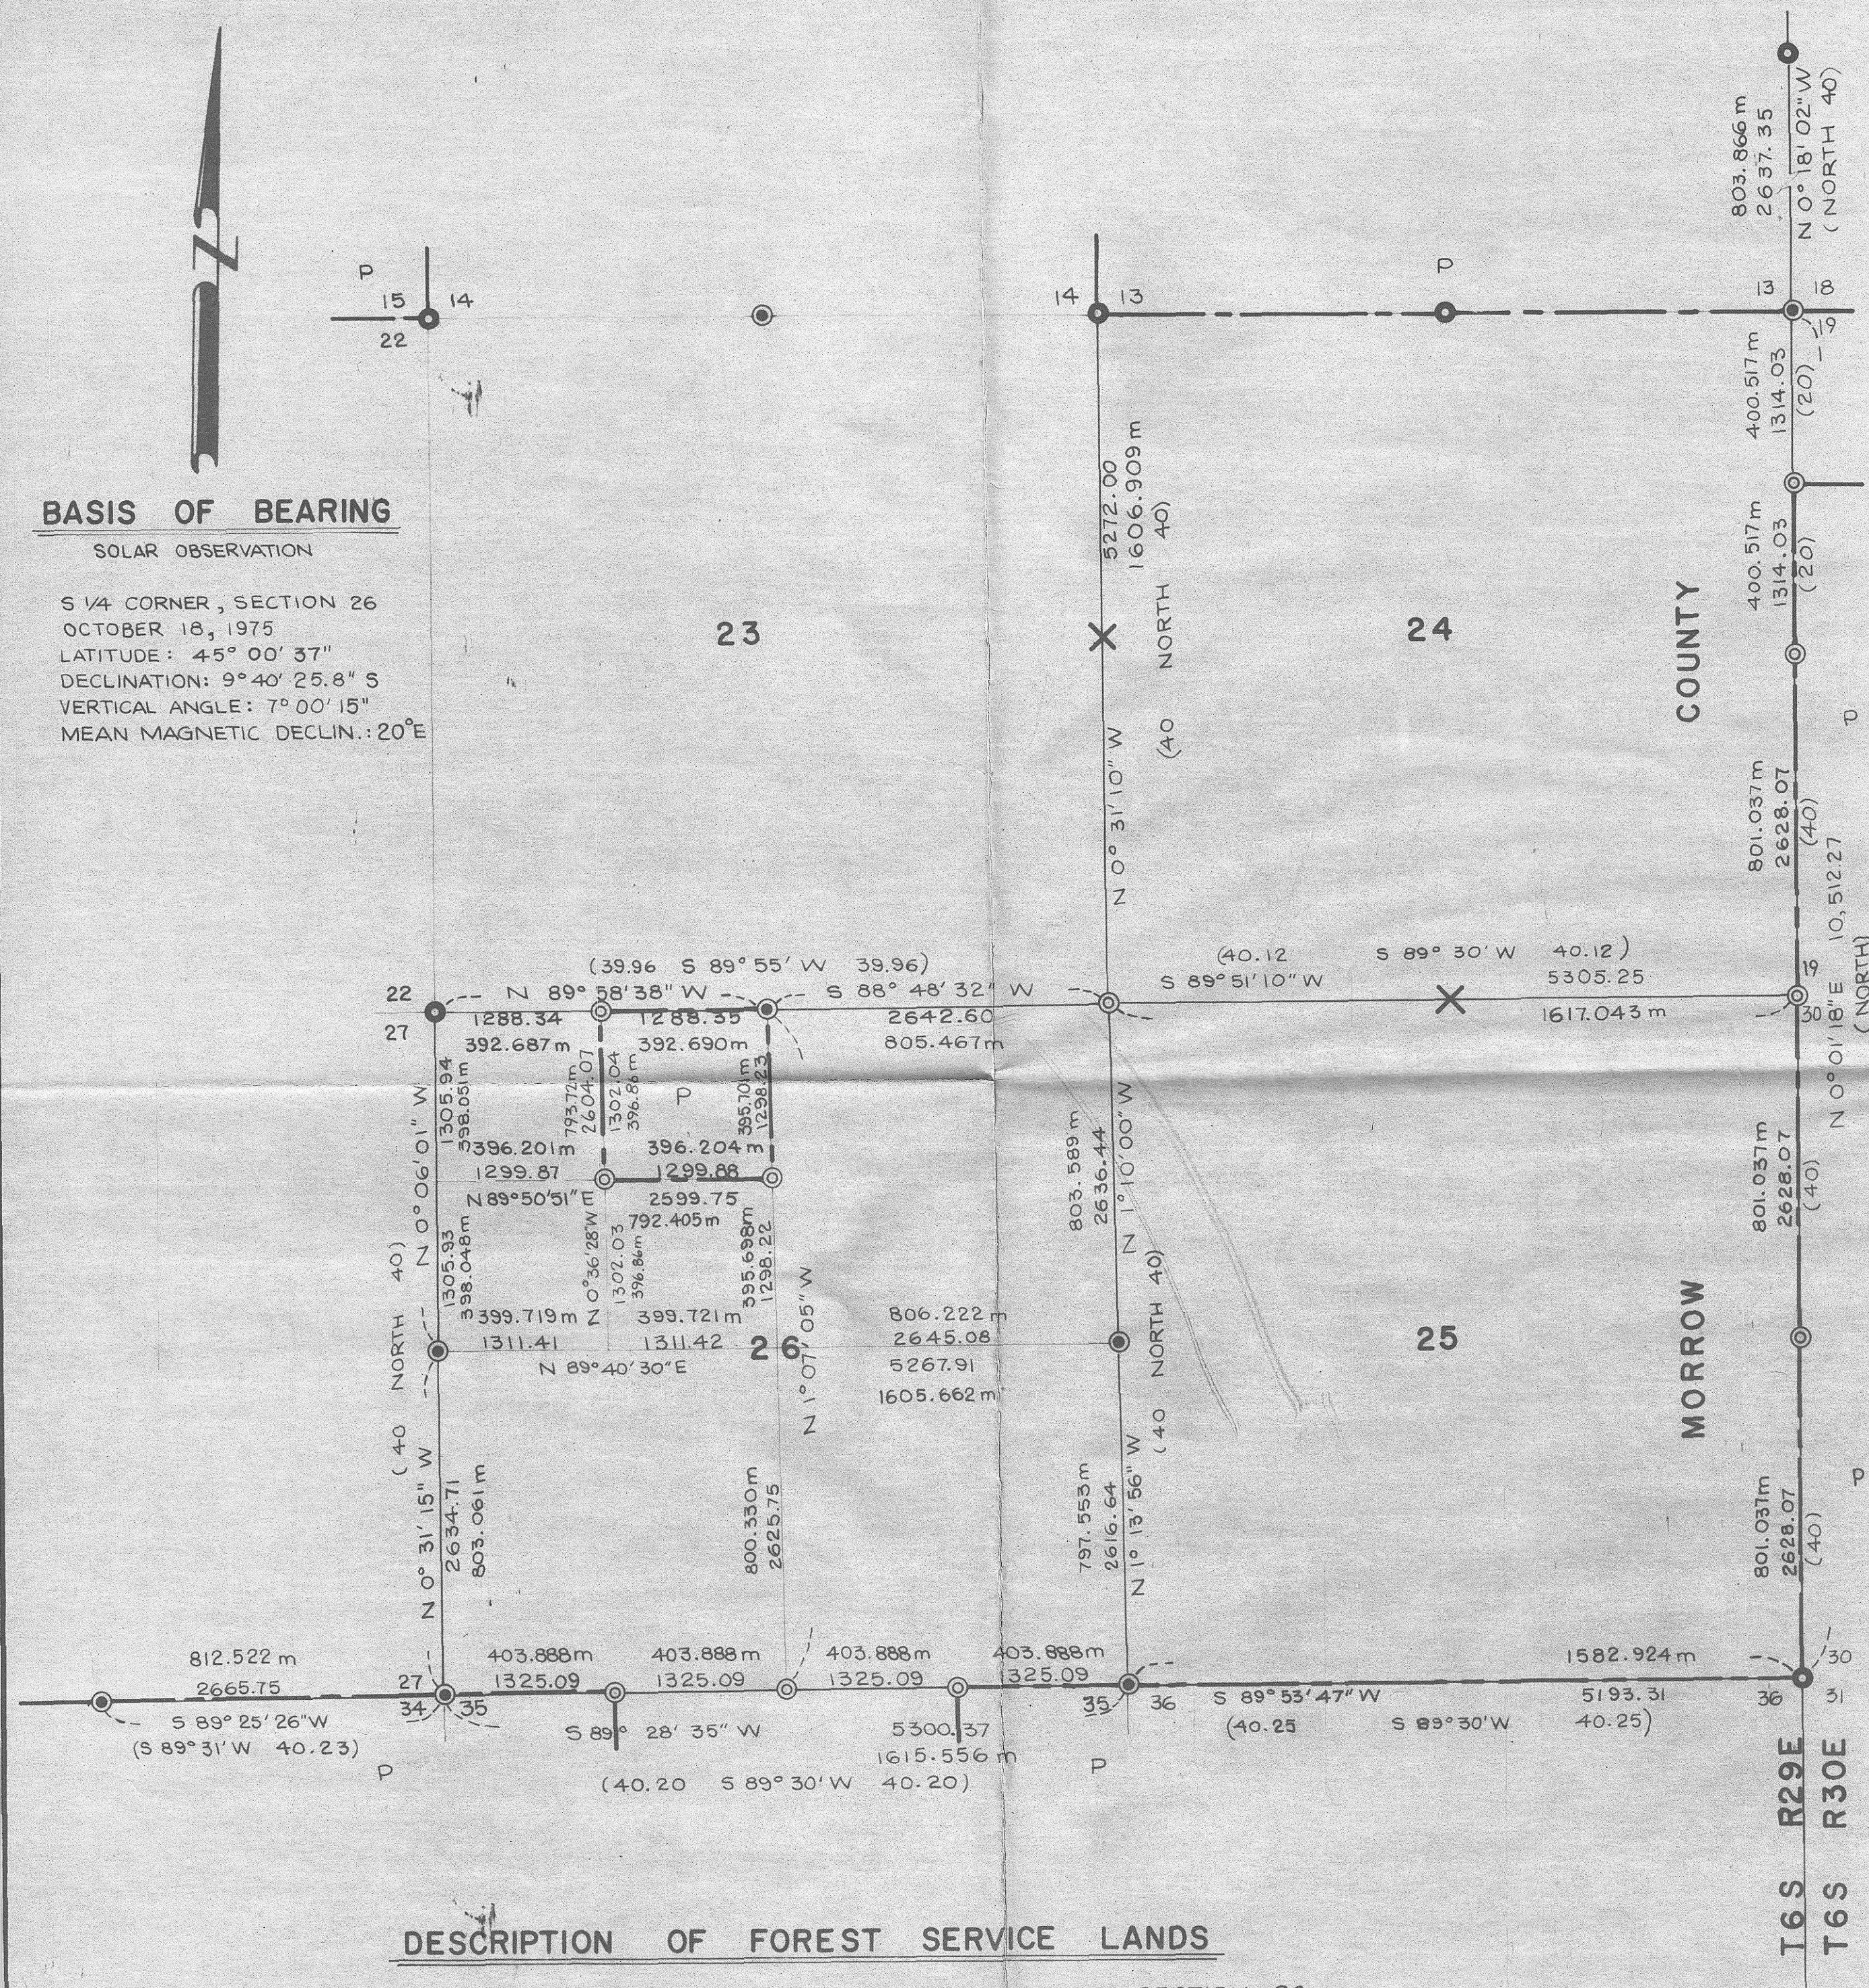

DESCRIPTION OF FOREST SERVICE LANDS

SECTION 23	SECTION 24	SECTION 25	SECTION 26
ENTIRE SECTION	ENTIRE SECTION	ENTIRE SECTION	S 1/2 NE 1/4 S 1/2, NW 1/4 NW 1/4, NW 1/4

SURVEYOR'S STATEMENT

I, DUANE I. GRIFFITH, REGISTERED LAND SURVEYOR IN THE STATE OF OREGON, HEREBY CERTIFY THAT THIS PLAT AND THE NOTES HEREON, OR ATTACHED, ARE A CORRECT REPRESENTATION OF THE SURVEY I MADE DURING OCTOBER AND NOVEMBER, 1975, FOR THE U.S. FOREST SERVICE, IN ACCORDANCE WITH THE STATUTES OF THE STATE OF OREGON AND WITH THE ARTICLE OF MY CONTRACT.

Duane I. Griffith
PLS 644

REGISTERED
PROFESSIONAL
LAND SURVEYOR

OREGON
JULY 10, 1968
DUANE I. GRIFFITH
644

LEGEND

- FOUND G.L.O. CORNER, REMONUMENTED IN 1974 WITH BRASS CAP
- FOUND G.L.O. CORNER, SET 2 1/2" x 30" IRON PIPE WITH BRASS CAP
- ⊙ SET 2 1/2" x 30" IRON PIPE WITH BRASS CAP AT PROPORTIONATE DISTANCE
- X CORNER SEARCHED FOR - NOT FOUND
- P PRIVATELY OWNED LANDS
- () RECORD BEARING AND DISTANCE
- 123m METRIC EQUIVALENT
- FOREST SERVICE BOUNDARY

NOTE

FOR MONUMENTATION RECORDS, SEE MONUMENTATION SHEETS FILED SEPARATELY

BAGETT, GRIFFITH & ASSOCIATES

La Grande, Oregon

Map of Survey

SECTIONS 23 - 24 - 25 - 26

OF

T6S R29E W.M.

MORROW COUNTY, OREGON

SURVEYED FOR	UMATILLA NATIONAL FOREST
SURVEYED BY	D. I. G. NOV. 1975
Scale: 1" = 1000'	Drawn by: f.d.g. DEC. 1975

C-9-K-288