


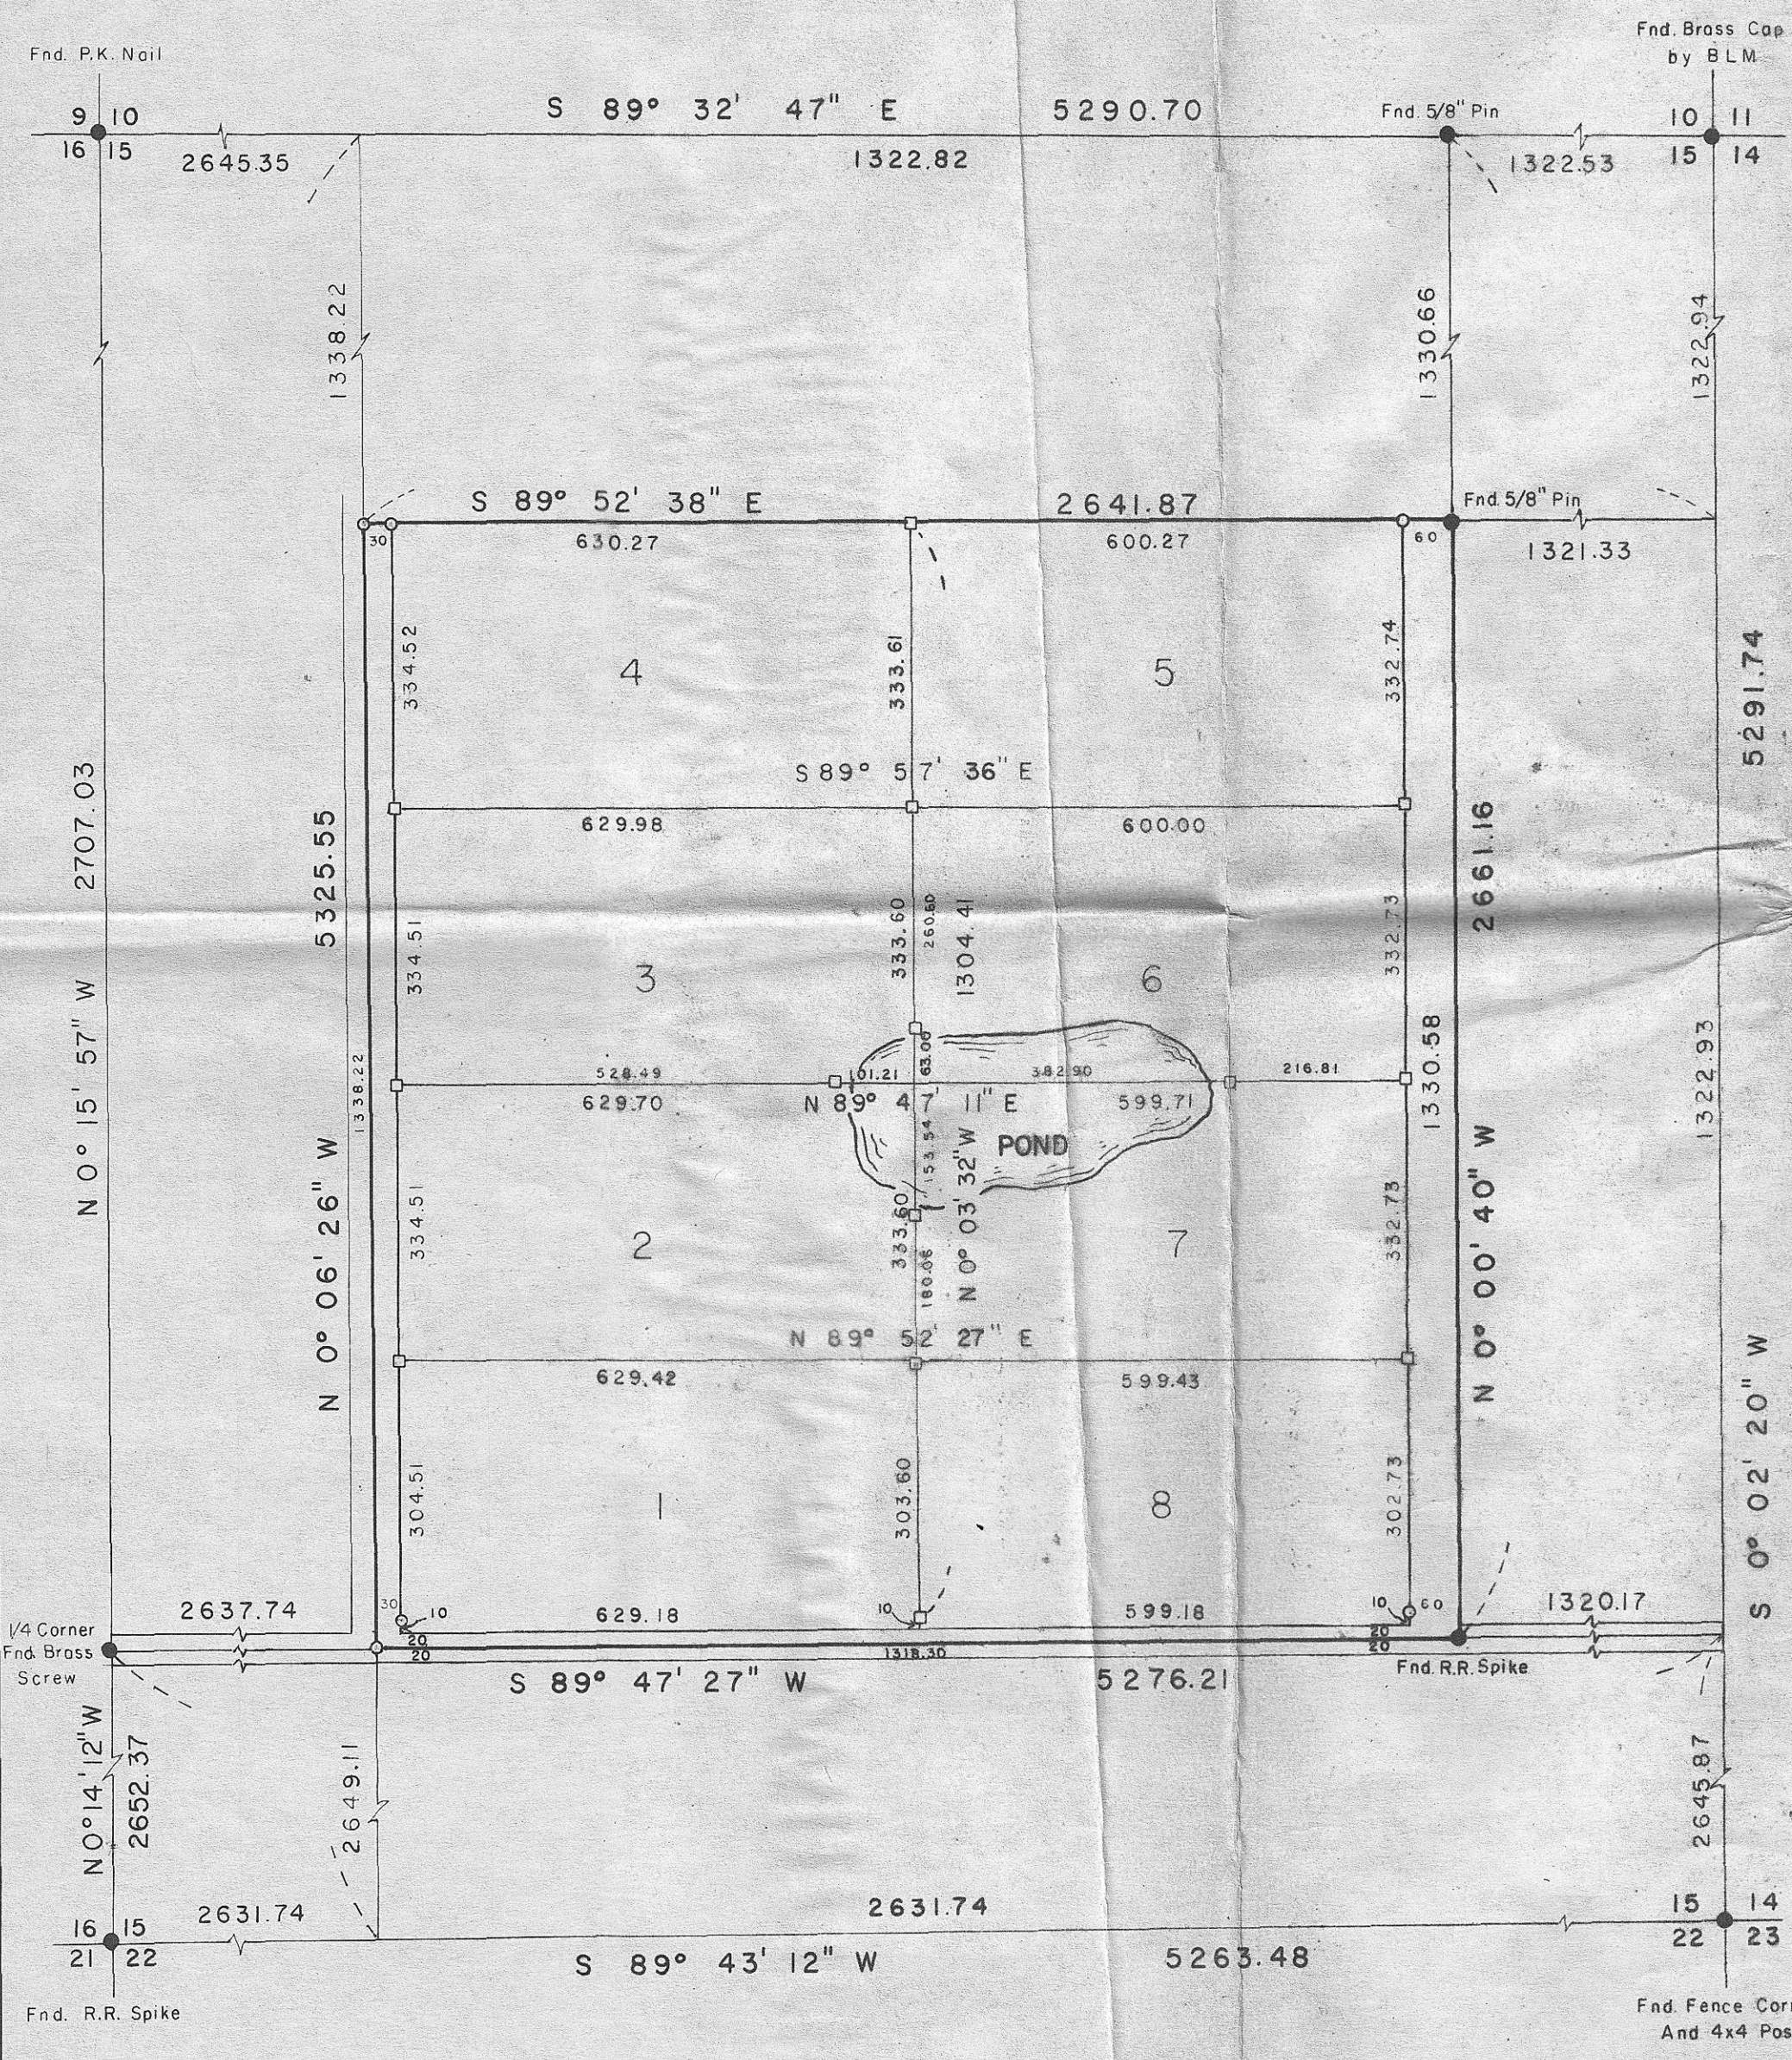

Basis of Bearing
Solar Observations
at Center 1/4 Corner

LEGEND

- Found Monument of Record
- Set 5/8" x 30" Iron Pin
- Set 1/2" x 24" Iron Pin

REFERENCE MATERIAL

Corp of Engineer Datum on John Day Dam
Survey by Dave Krumbien for McKenzie
Survey by Richard Rogers for Columbia Pacific Resources Inc.
Survey by Dave Krumbien for Wilson



BAGETT, GRIFFITH & ASSOCIATES		
La Grande, Oregon		
Map of Survey		
SW1/4 of the NE 1/4,		
Section 15, T4N, R25E, WM		
Morrow County, Oregon		
SURVEYED FOR	Jim Weems	
SURVEYED BY	DIG	Jan. 1977
Scale: 1" = 200'	Drawn by: dad	Jan. 1977

17
#13-K-
#293