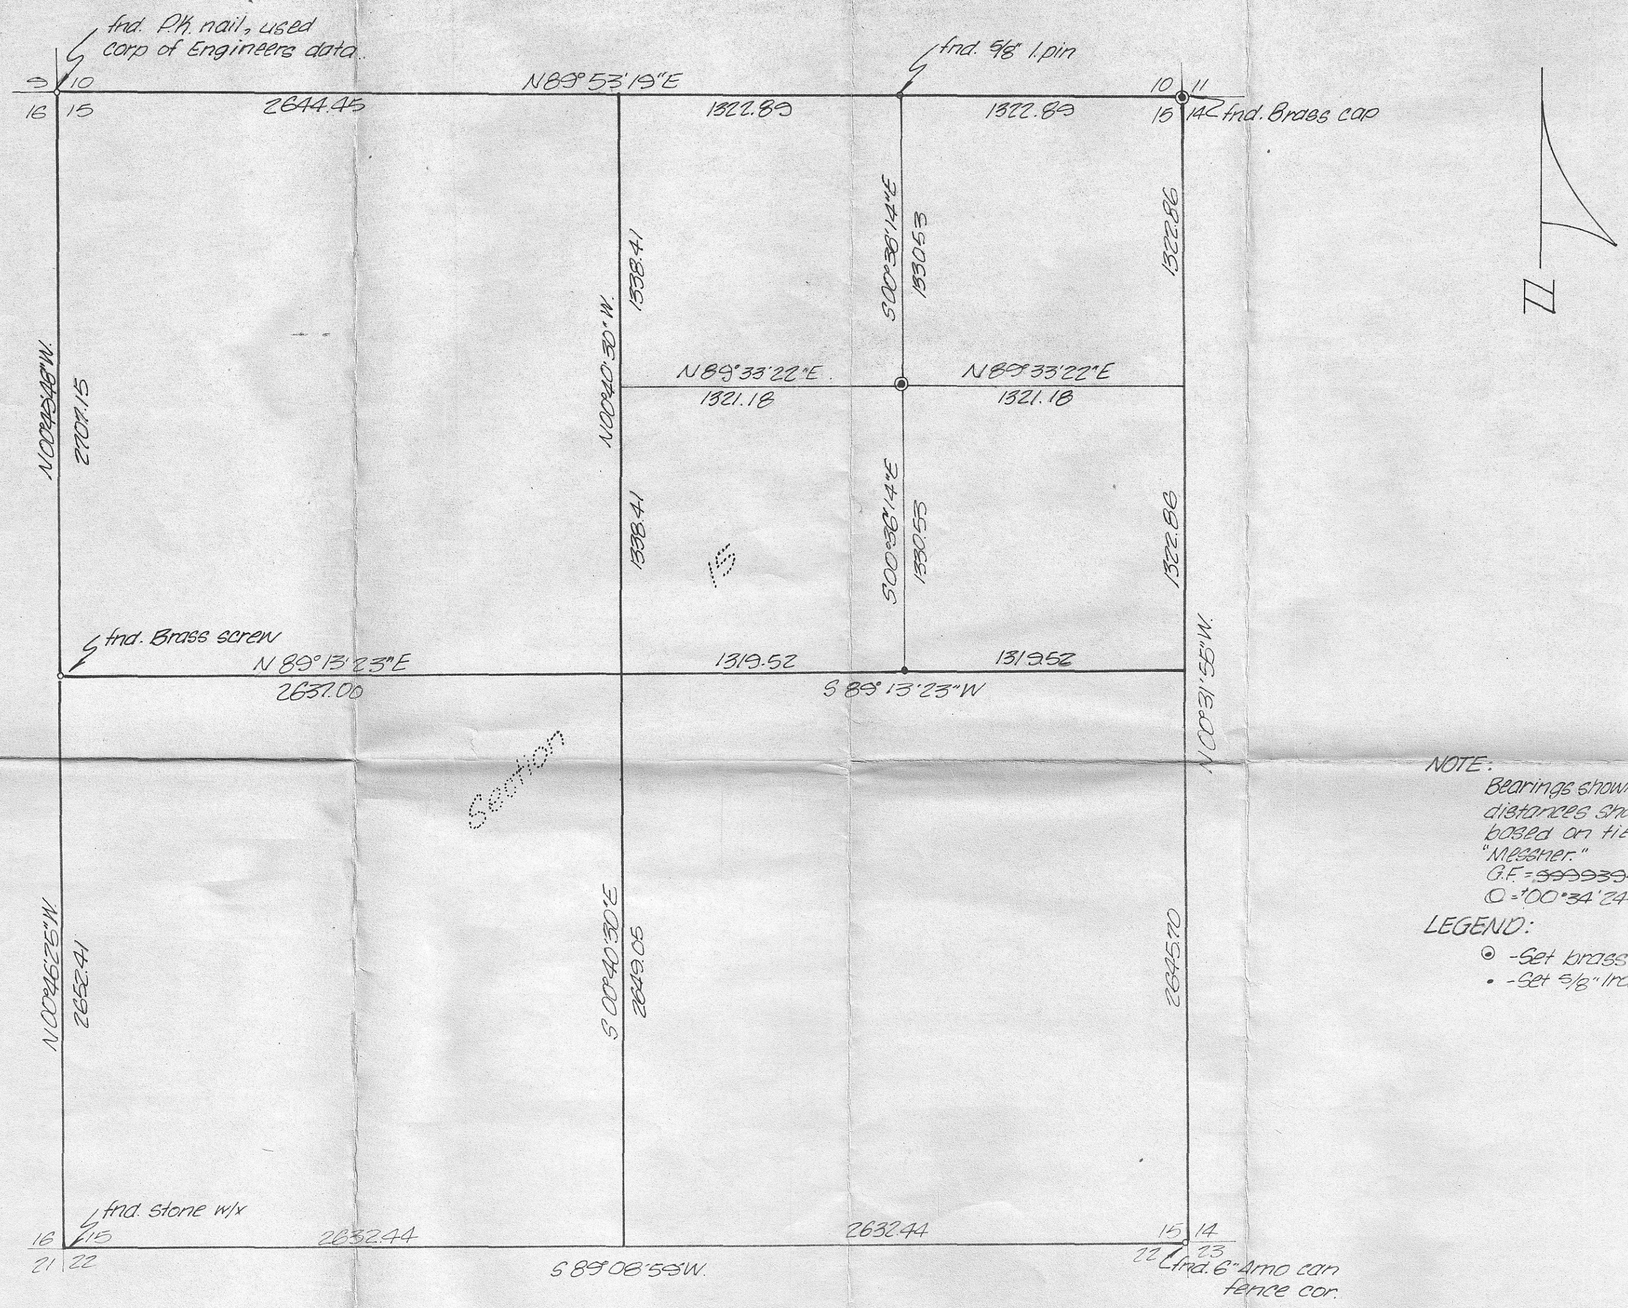

NOTE:
Bearings shown are grid and distances shown are true, based on ties to N.G.S. Station "Messner."
G.F. = 99993948
⊙ = +00°34'24"

LEGEND:
⊙ - Set brass cap
• - Set 5/8" Iron pin

C-102-K-334

Revised April 5, 1978, by G.G.R.

REGISTERED PROFESSIONAL LAND SURVEYOR
David H. Krumbein
OREGON
JULY 17, 1970
DAVID H. KRUMBEIN
933

KRUMBEIN ENGINEERING CO.
ENGINEERS – SURVEYORS – PLANNERS
221 S. Main, Pendleton, Oregon

Survey for
ETHYL McKENZIE
N.E.1/4 Section 15, T4N, R25E, W.M.

SCALE	1" = 500'
DATE	APR 5, 1978
DRN. BY	G.G.R.
CKD. BY	D.H.K.
DRNG. NO.	76-65C