


C-340

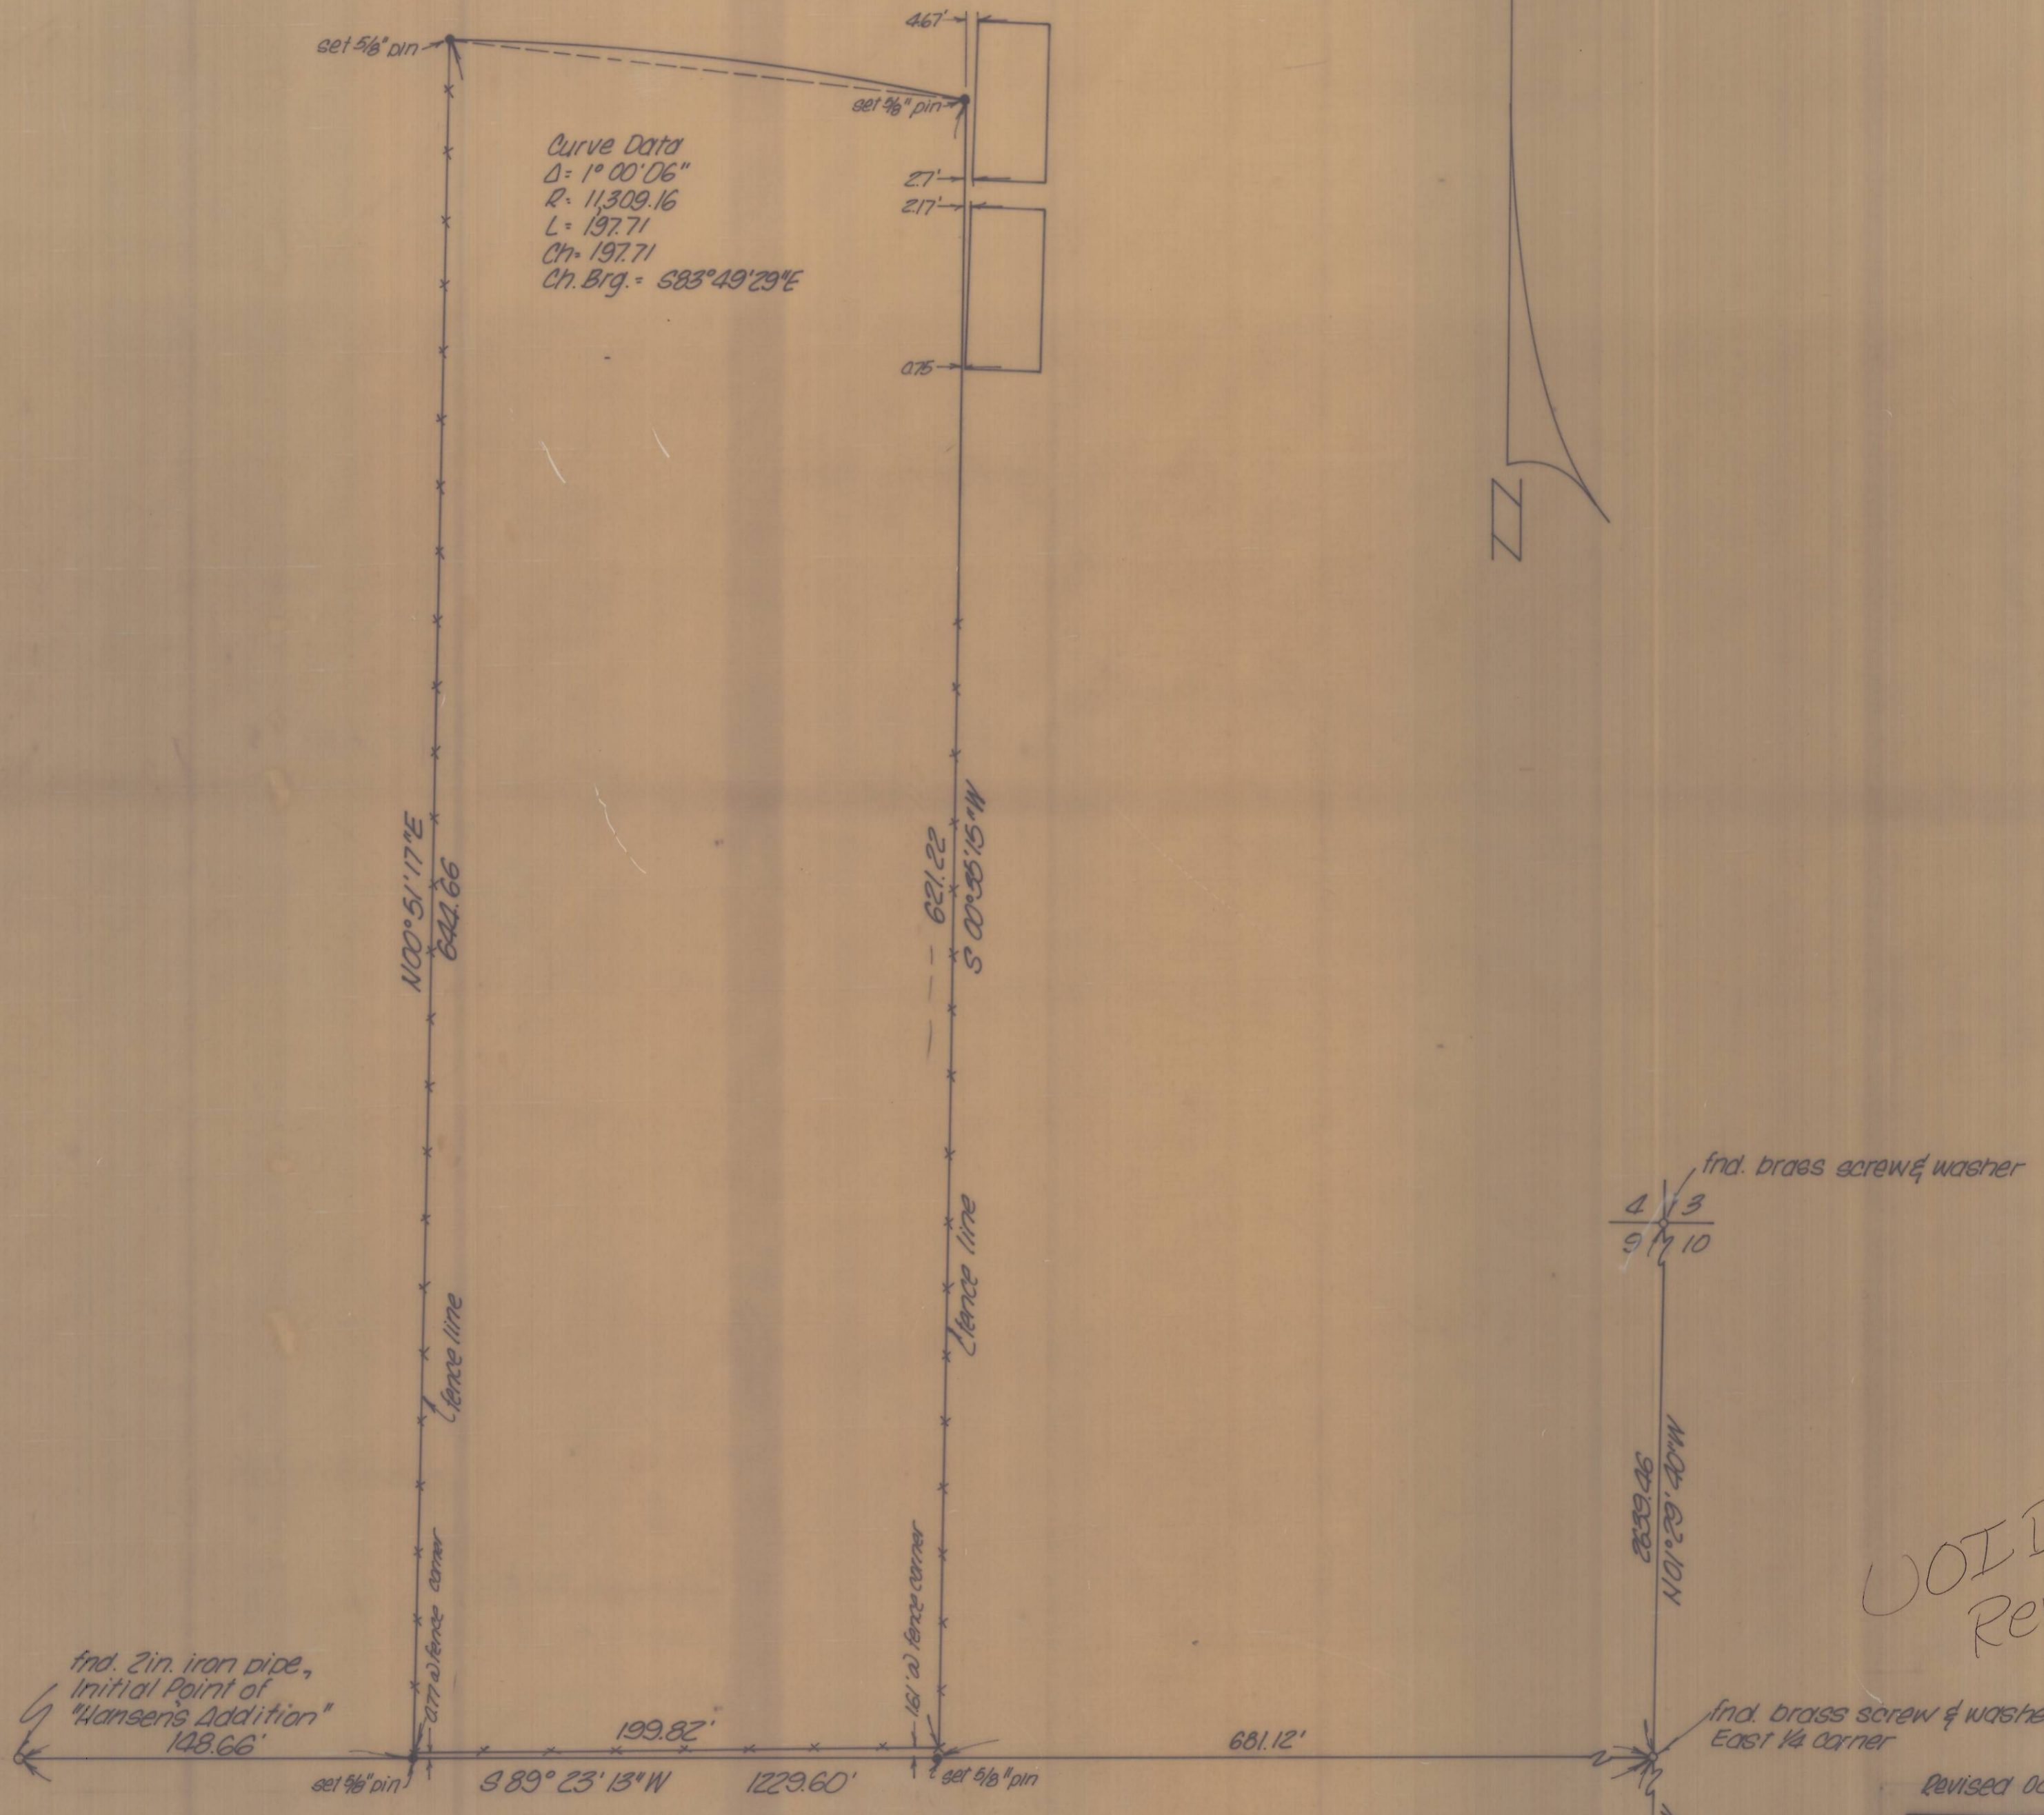

C-109-K-340

VOID
 Revised
 10-18-79

REGISTERED
 PROFESSIONAL
 LAND SURVEYOR
 David H. Krumbein
 OREGON
 JULY 17, 1959
 DAVID H. KRUMBEIN
 933

K KRUMBEIN ENGINEERING CO. ENGINEERS - SURVEYORS - PLANNERS 221 S. Main, Pendleton, Oregon.	SCALE 1" = 50'
	DATE Oct. 26, 1977
Survey for BOARDMAN INDUSTRIAL BUILDERS, INC. Parcel in NE 1/4, Sec. 9, T.4N, R.25E, W.M.	DRN. BY P.L.S.
	CHKD. BY D.H.K.
	DRNG. NO. #77-58 C

C-109K