


BEARINGS BASED ON E-W & SEC. 16, T.4N., R. 25E. W.M. BEING N. 89° 50' 30" E. SEE PREVIOUS WORK BY THIS COMPANY FILED WITH MORROW COUNTY SURVEYOR. ALL DISTANCES AND BEARINGS ARE TRUE.

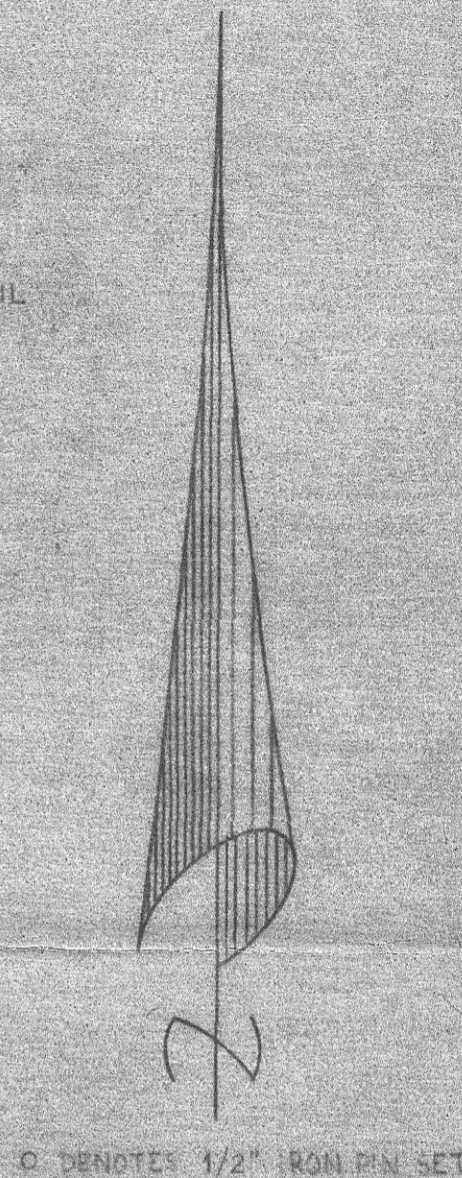

REGISTERED
PROFESSIONAL
LAND SURVEYOR
Wayne Harris
DEP. OF
MAY 6, 1988
WAYNE D. HARRIS
146

SURVEY FOR				
CLARENCE ANDERSON				
PARCEL IN NE 1/4 SEC 16, T.4N. R. 25E. W.M. MORROW COUNTY, OREGON				
WAYNE HARRIS CO. INC.				
ENGINEERS - SURVEYORS PERDLETON, ORE				
SCALE	DATE	DWN	CHK	DWG. NO
1"=400'	01-17-78	CG	LD	78-1903