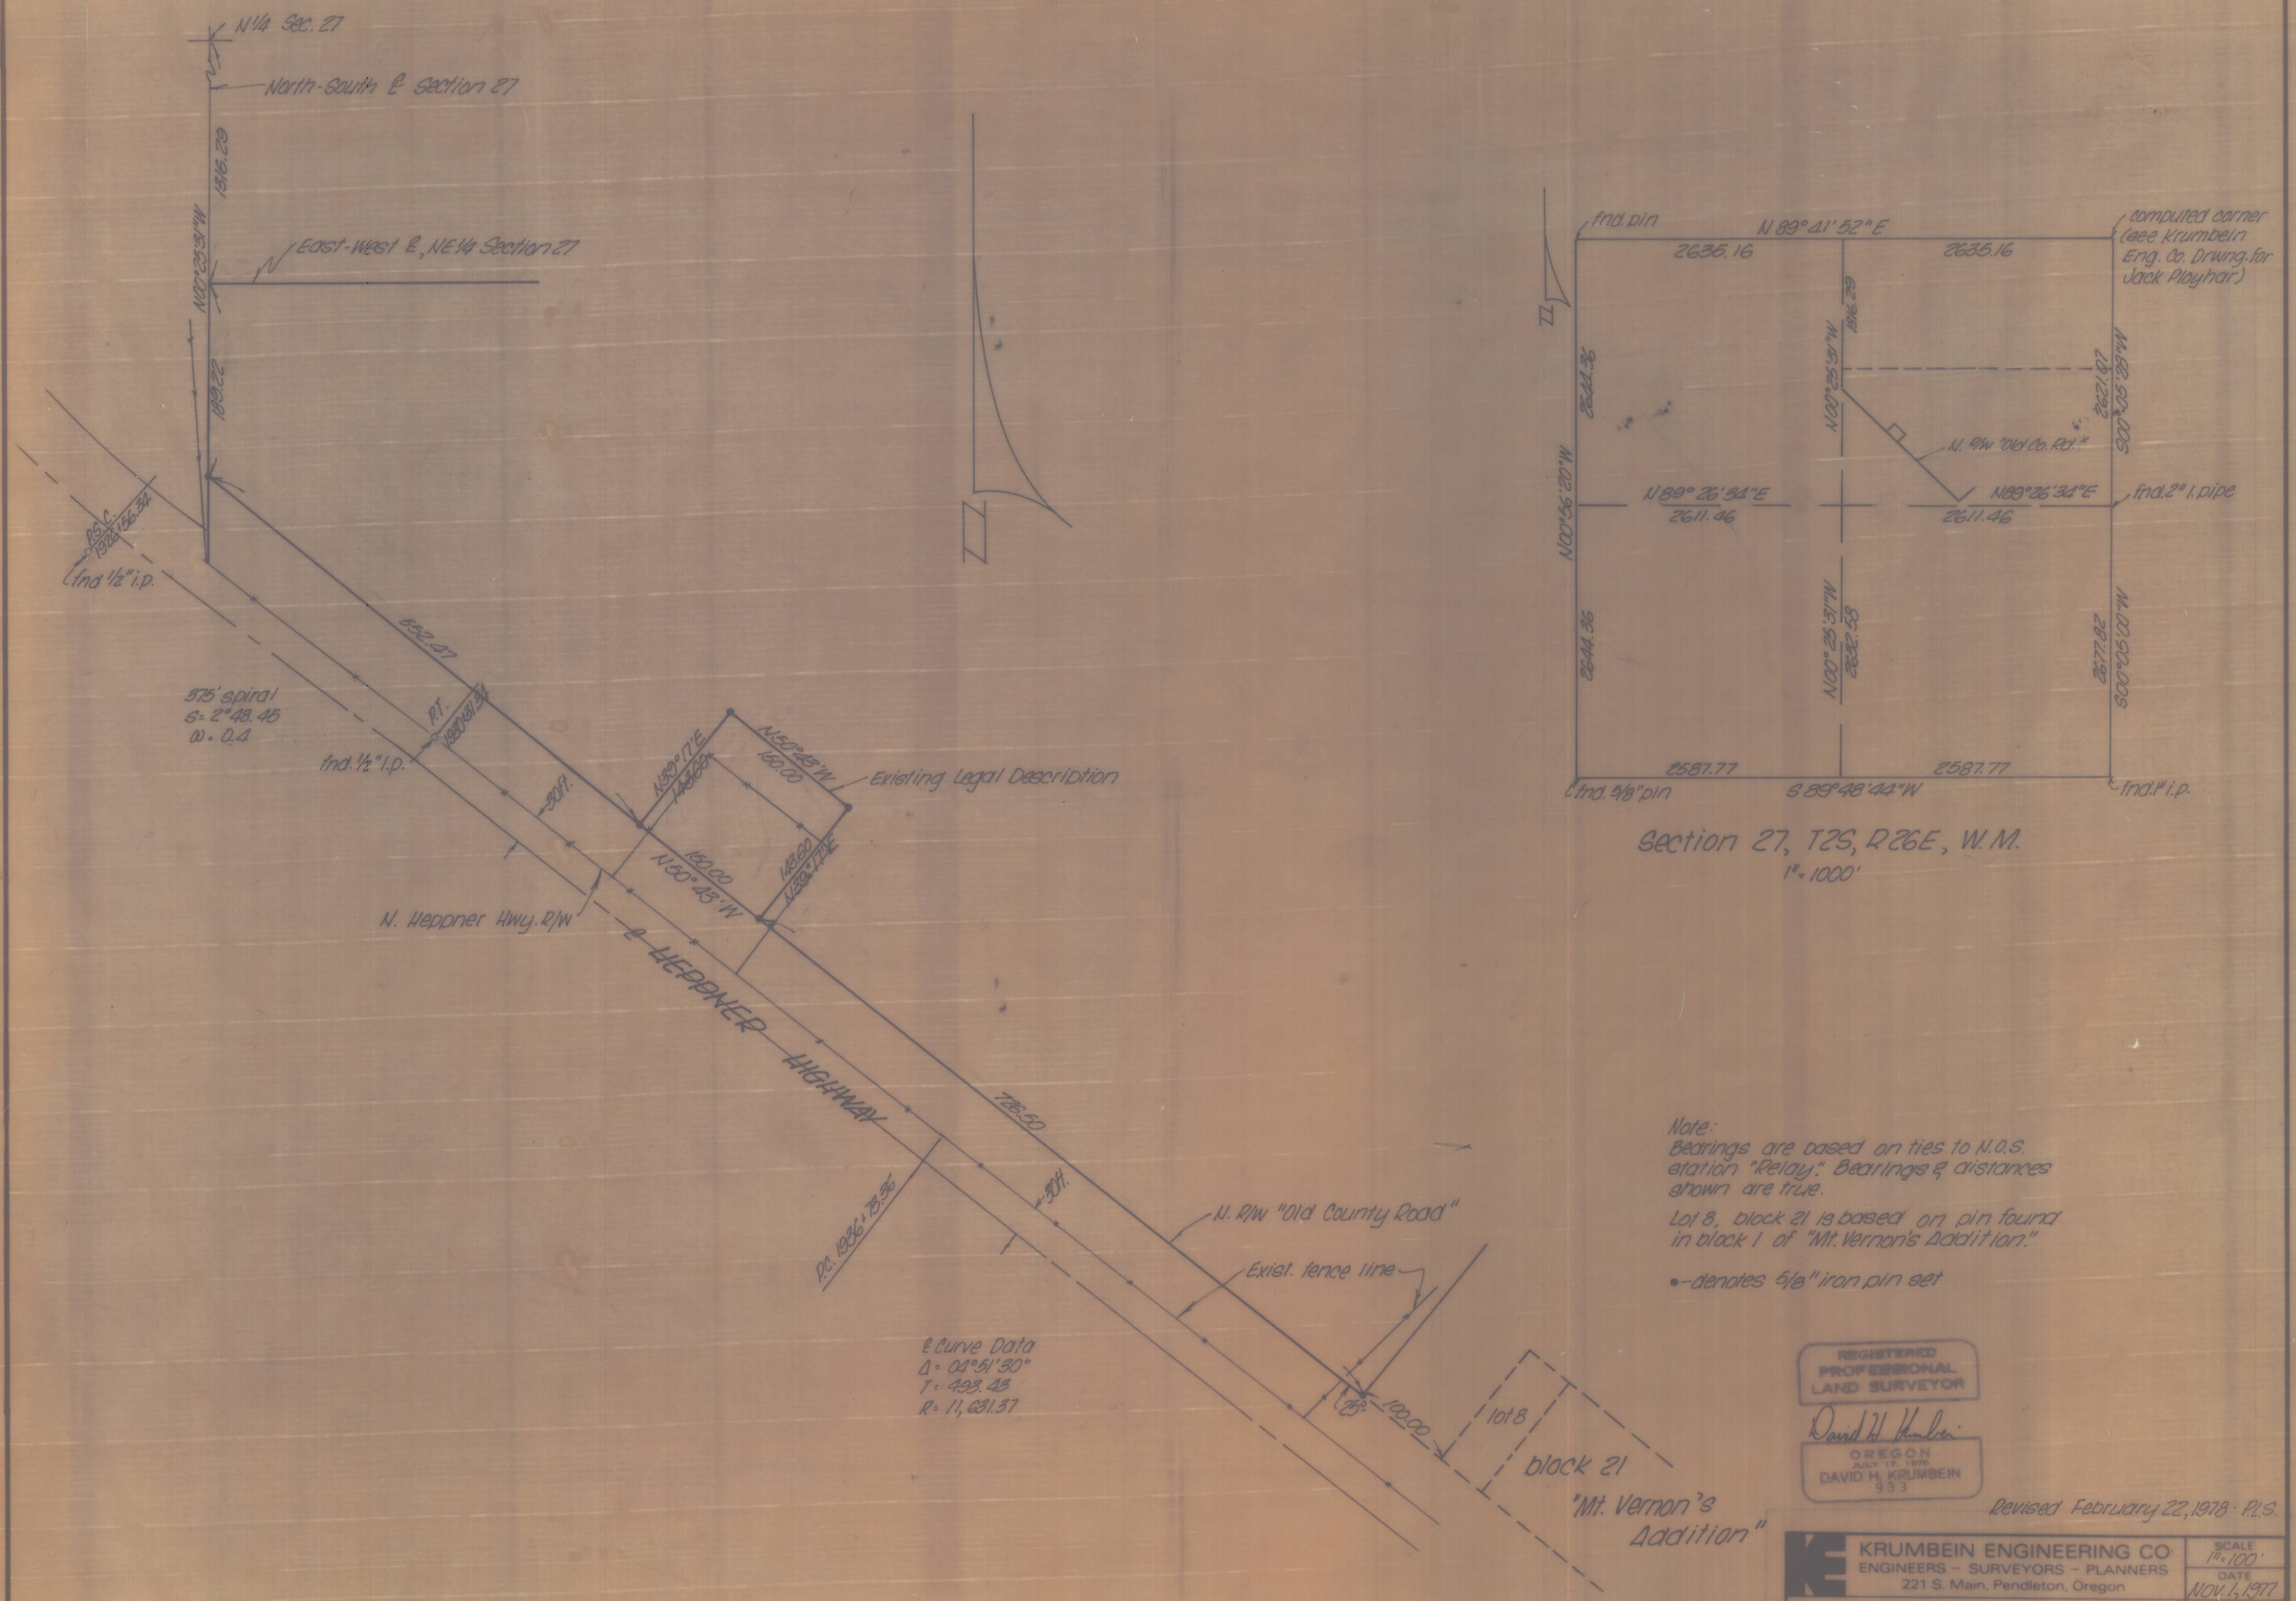

Section 27, T2S, R26E, W.M.
1" = 1000'

Note:
Bearings are based on ties to N.G.S. station "Relay." Bearings & distances shown are true.

Lot 8, block 21 is based on pin found in block 1 of "Mt. Vernon's Addition."

•-denotes 5/8" iron pin set

REGISTERED PROFESSIONAL LAND SURVEYOR
David H. Krumbein
OREGON
JULY 17 1970
DAVID H. KRUMBEIN
933

Revised February 22, 1978 - P.L.S.

KRUMBEIN ENGINEERING CO
ENGINEERS – SURVEYORS – PLANNERS
221 S. Main, Pendleton, Oregon

SCALE	1" = 100'
DATE	NOV. 1, 1977
DRN. BY	P.L.S.
CKD. BY	T.E.H.
DRWG. NO.	#77-536

Survey for
DEL DIPED
Parcel in NE¼, Section 27, T2S, R26E, W.M.

347

C-146-K-347

C-#146 k