


SCALE: 1"=2000'

NOTE: BEARINGS, DISTANCES AND COORDINATES ARE GRID, OREGON NORTH ZONE.
θ = + 0° 47' 52"
GRID FACTOR = 0.9999332

LEGEND

- BRASS CAP FOUND
- ⊙ " " " BY OTHERS
- CALC. COORDINATES
- * COORDINATES FROM D.W. KRUMBIEN, O.R.L.S. 933
- Set 3/4" x 30" I. Pipe

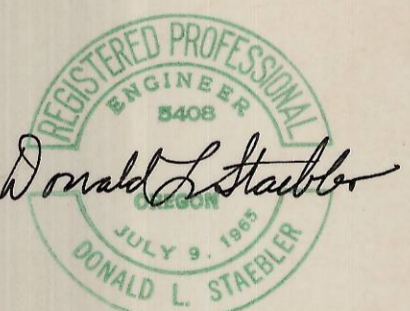

Revised: 1-3-75; 1-13-75
1/2" = 100' Scale of Plan
2014 S.W. Corner of Sec.
20-41-27


SURVEY FOR
ARNOLD BRAAT
S.E. CORNER & EAST LINE, SEC. 20,
T. 4 N. R. 27 E. W.M.

Dwn: HFS Date: 5-28-74 Scale: 1"=2000'
DONALD L. STAEBLER
CONSULTING ENGINEER
P.O. BOX 91
PENDLETON OREGON 97801

386

C-211-K-386

C-#211-K

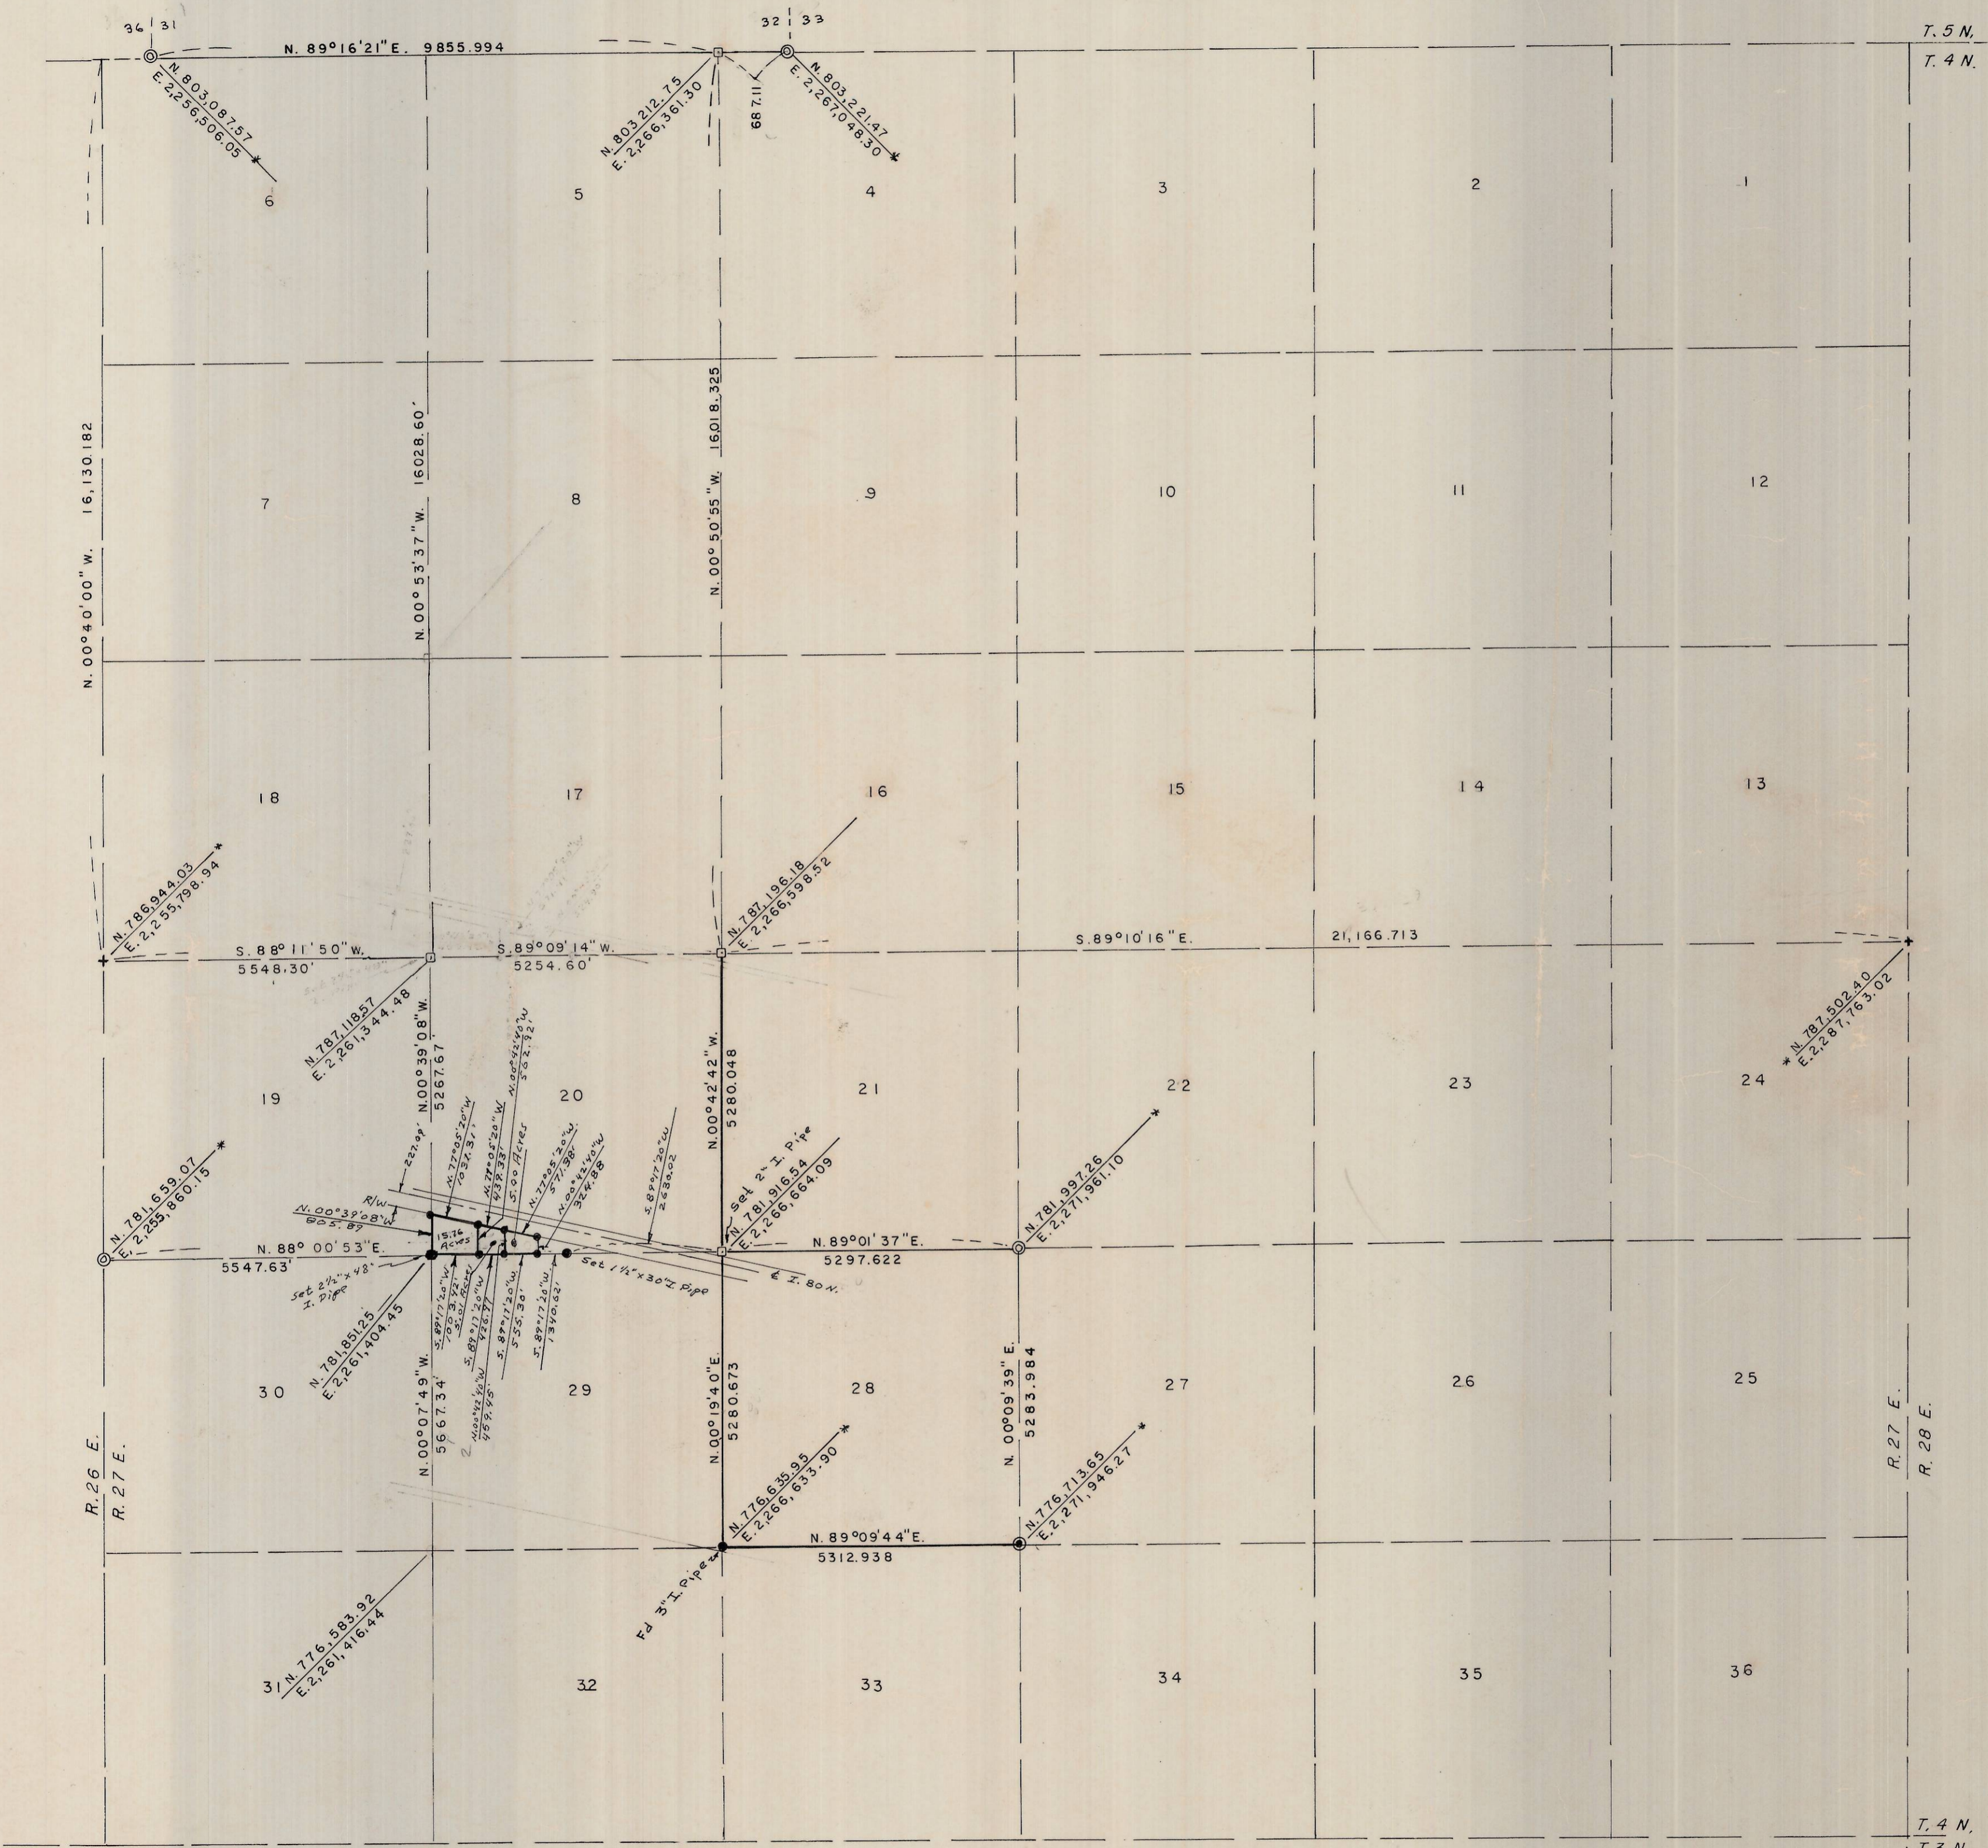

T. 5 N.
T. 4 N.

R. 26 E.
R. 27 E.
R. 28 E.

T. 4 N.
T. 3 N.