


BOARDMAN DEVELOPMENT COMPANY, INC. LAND SURVEY

EXHIBIT "A"

FOUND SECTION
CORNER BRASSCAP

TRACT	LOCATION	TRAVERSE	AREA IN ACRES	CURVE DATA				


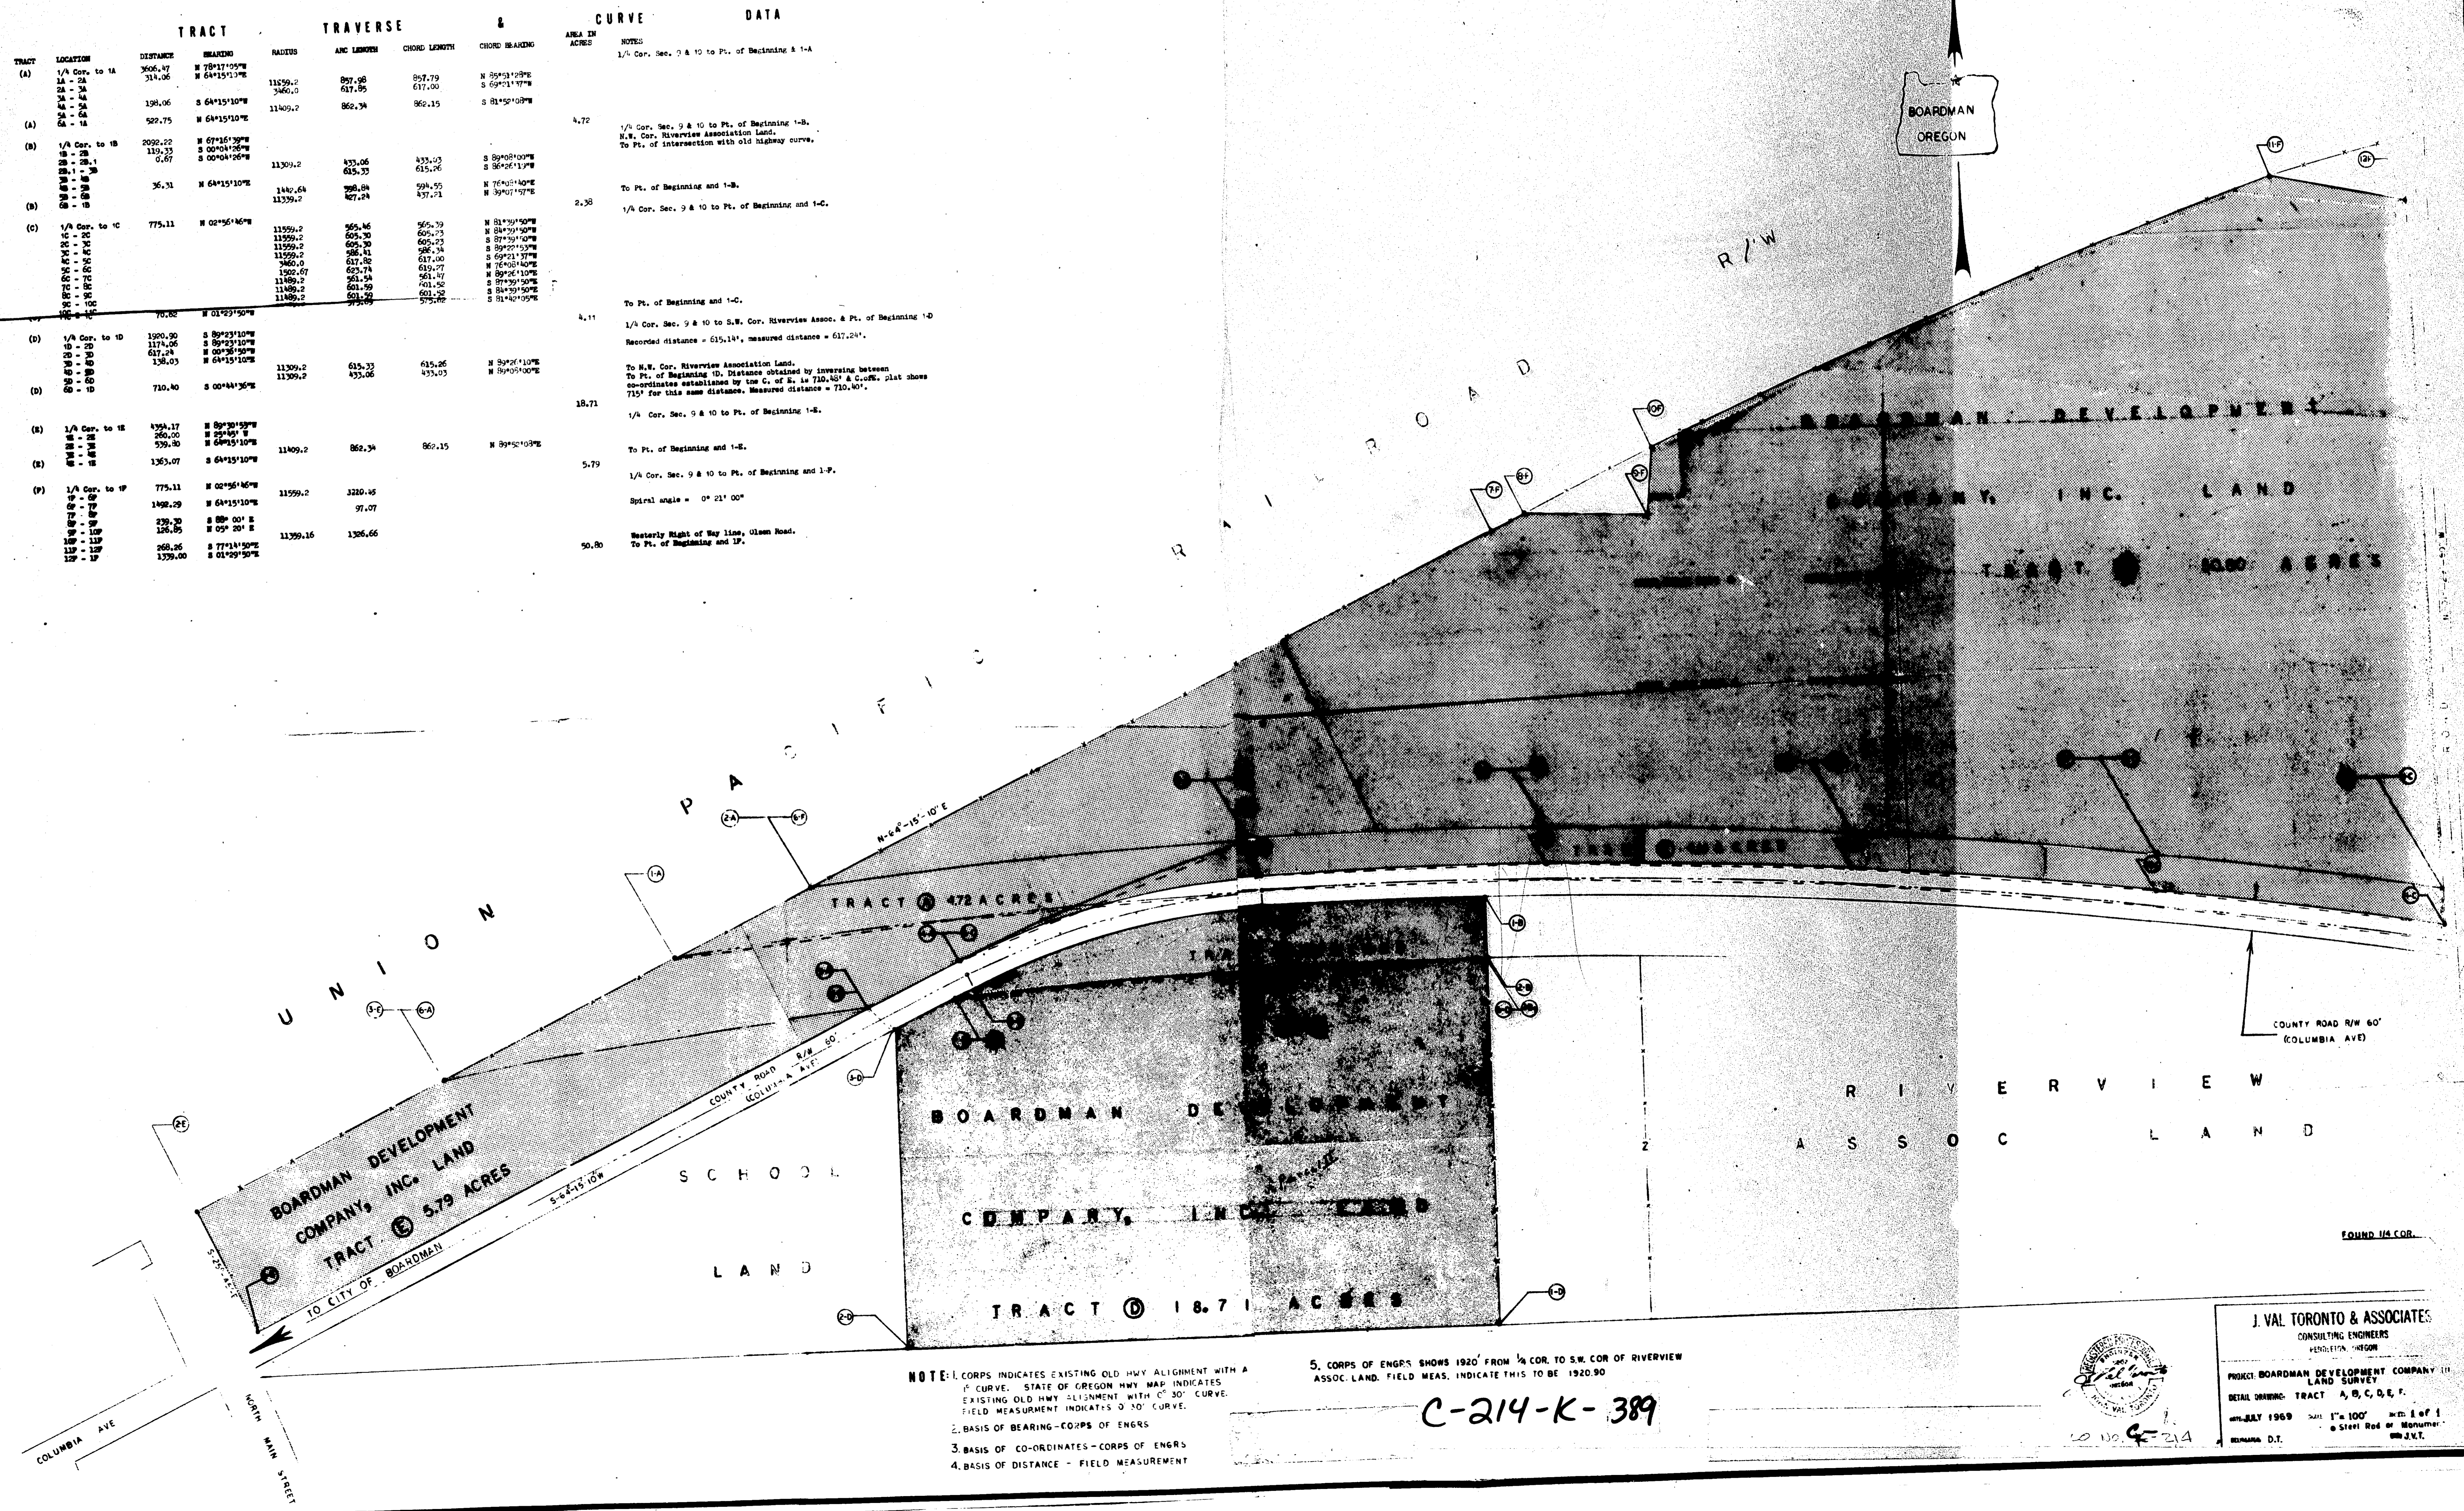

NOTE: 1. CORPS INDICATES EXISTING OLD HWY ALIGNMENT WITH A 30' CURVE. STATE OF OREGON HWY MAP INDICATES EXISTING OLD HWY ALIGNMENT WITH 30' CURVE. FIELD MEASUREMENT INDICATES 30' CURVE.
2. BASIS OF BEARING - CORPS OF ENGRS
3. BASIS OF CO-ORDINATES - CORPS OF ENGRS
4. BASIS OF DISTANCE - FIELD MEASUREMENT
5. CORPS OF ENGRS SHOWS 1920' FROM 1/4 COR. TO S.W. COR. OF RIVERVIEW ASSOC. LAND. FIELD MEAS. INDICATE THIS TO BE 1920.90

C-214-K-389



J. VAL TORONTO & ASSOCIATES
CONSULTING ENGINEERS
PROJECT: BOARDMAN DEVELOPMENT COMPANY, INC.
LAND SURVEY
DETAIL DRAWING: TRACT A, B, C, D, E, F.
SCALE: 1" = 100'
SHEET: 1 of 1
BY: J.V.T.
CHECKED: D.T.