


- denotes Brass Cap set
- denotes Brass Cap found, set BLM 1939
- () denotes GLD record bearings & distances, 1939
- denotes Forest Service Boundary

NOTES:

Bearings are based on the line between the South one-quarter corner and the Southeast corner as established by the Bureau of Land Management in 1939 as recorded by the Morrow County Survey Records on Micro-Fiche of Township 5 South, Range 28 East, W.M., page 1 of 1.

All field notes for traverses for Section 23 are in Book 1. Notes used to set Brass Caps are in Book 1, pages 172-184. All accessory ties for corners set in Section 23 are described in Certified Record of Land Monumentation.

Computations for all corners set are based on the Manual of Surveying Instruction 1973, Chapter 5.

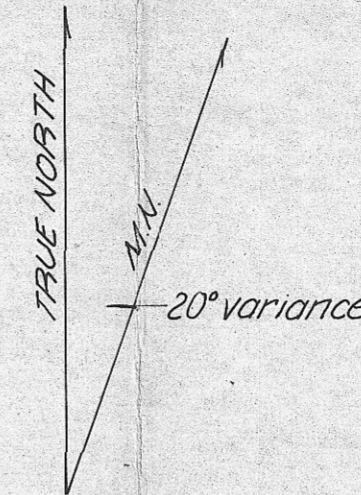


LEGAL DESCRIPTION

US Forest Service ownership; the West half of the Southwest one-quarter; all of the Northeast one-quarter, and the Northeast one-quarter of the Southeast one-quarter of Section 23. All being in Township 5 South, Range 28 East of the Willamette Meridian, County of Morrow.

I, Terry E. Hamby, a registered land surveyor in the State of Oregon, hereby certify that this plat and the notes hereon, or attached, are a correct representation of a survey I performed during August and September, 1979, for the U.S. Forest Service in accordance with the statutes of the State of Oregon and with the Articles of my contract.

Terry E. Hamby (s) Terry E. Hamby
Registered Land Surveyor
Oregon License No. 1638

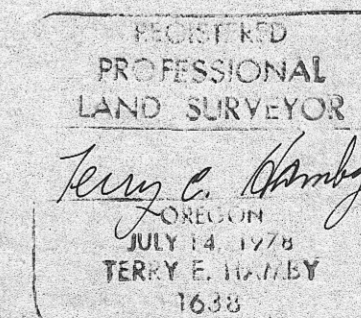

RECEIVED BY
Morrow County Surveyor
Date 9-7-79
Rec'd By M.L.J.
No. #252-K

Sheet 1 of 2

K KRUMBEIN ENGINEERING CO. ENGINEERS - SURVEYORS - PLANNERS 221 S. Main, Pendleton, Oregon	SCALE 1" = 500'
	DATE Sept. 6, 1979
Survey for U.S. FOREST SERVICE Section 23, T5S, R28E, W.M.	
DRN. BY M.H.	DRNG. NO. 79-61C
CKD BY T.E.H.	