


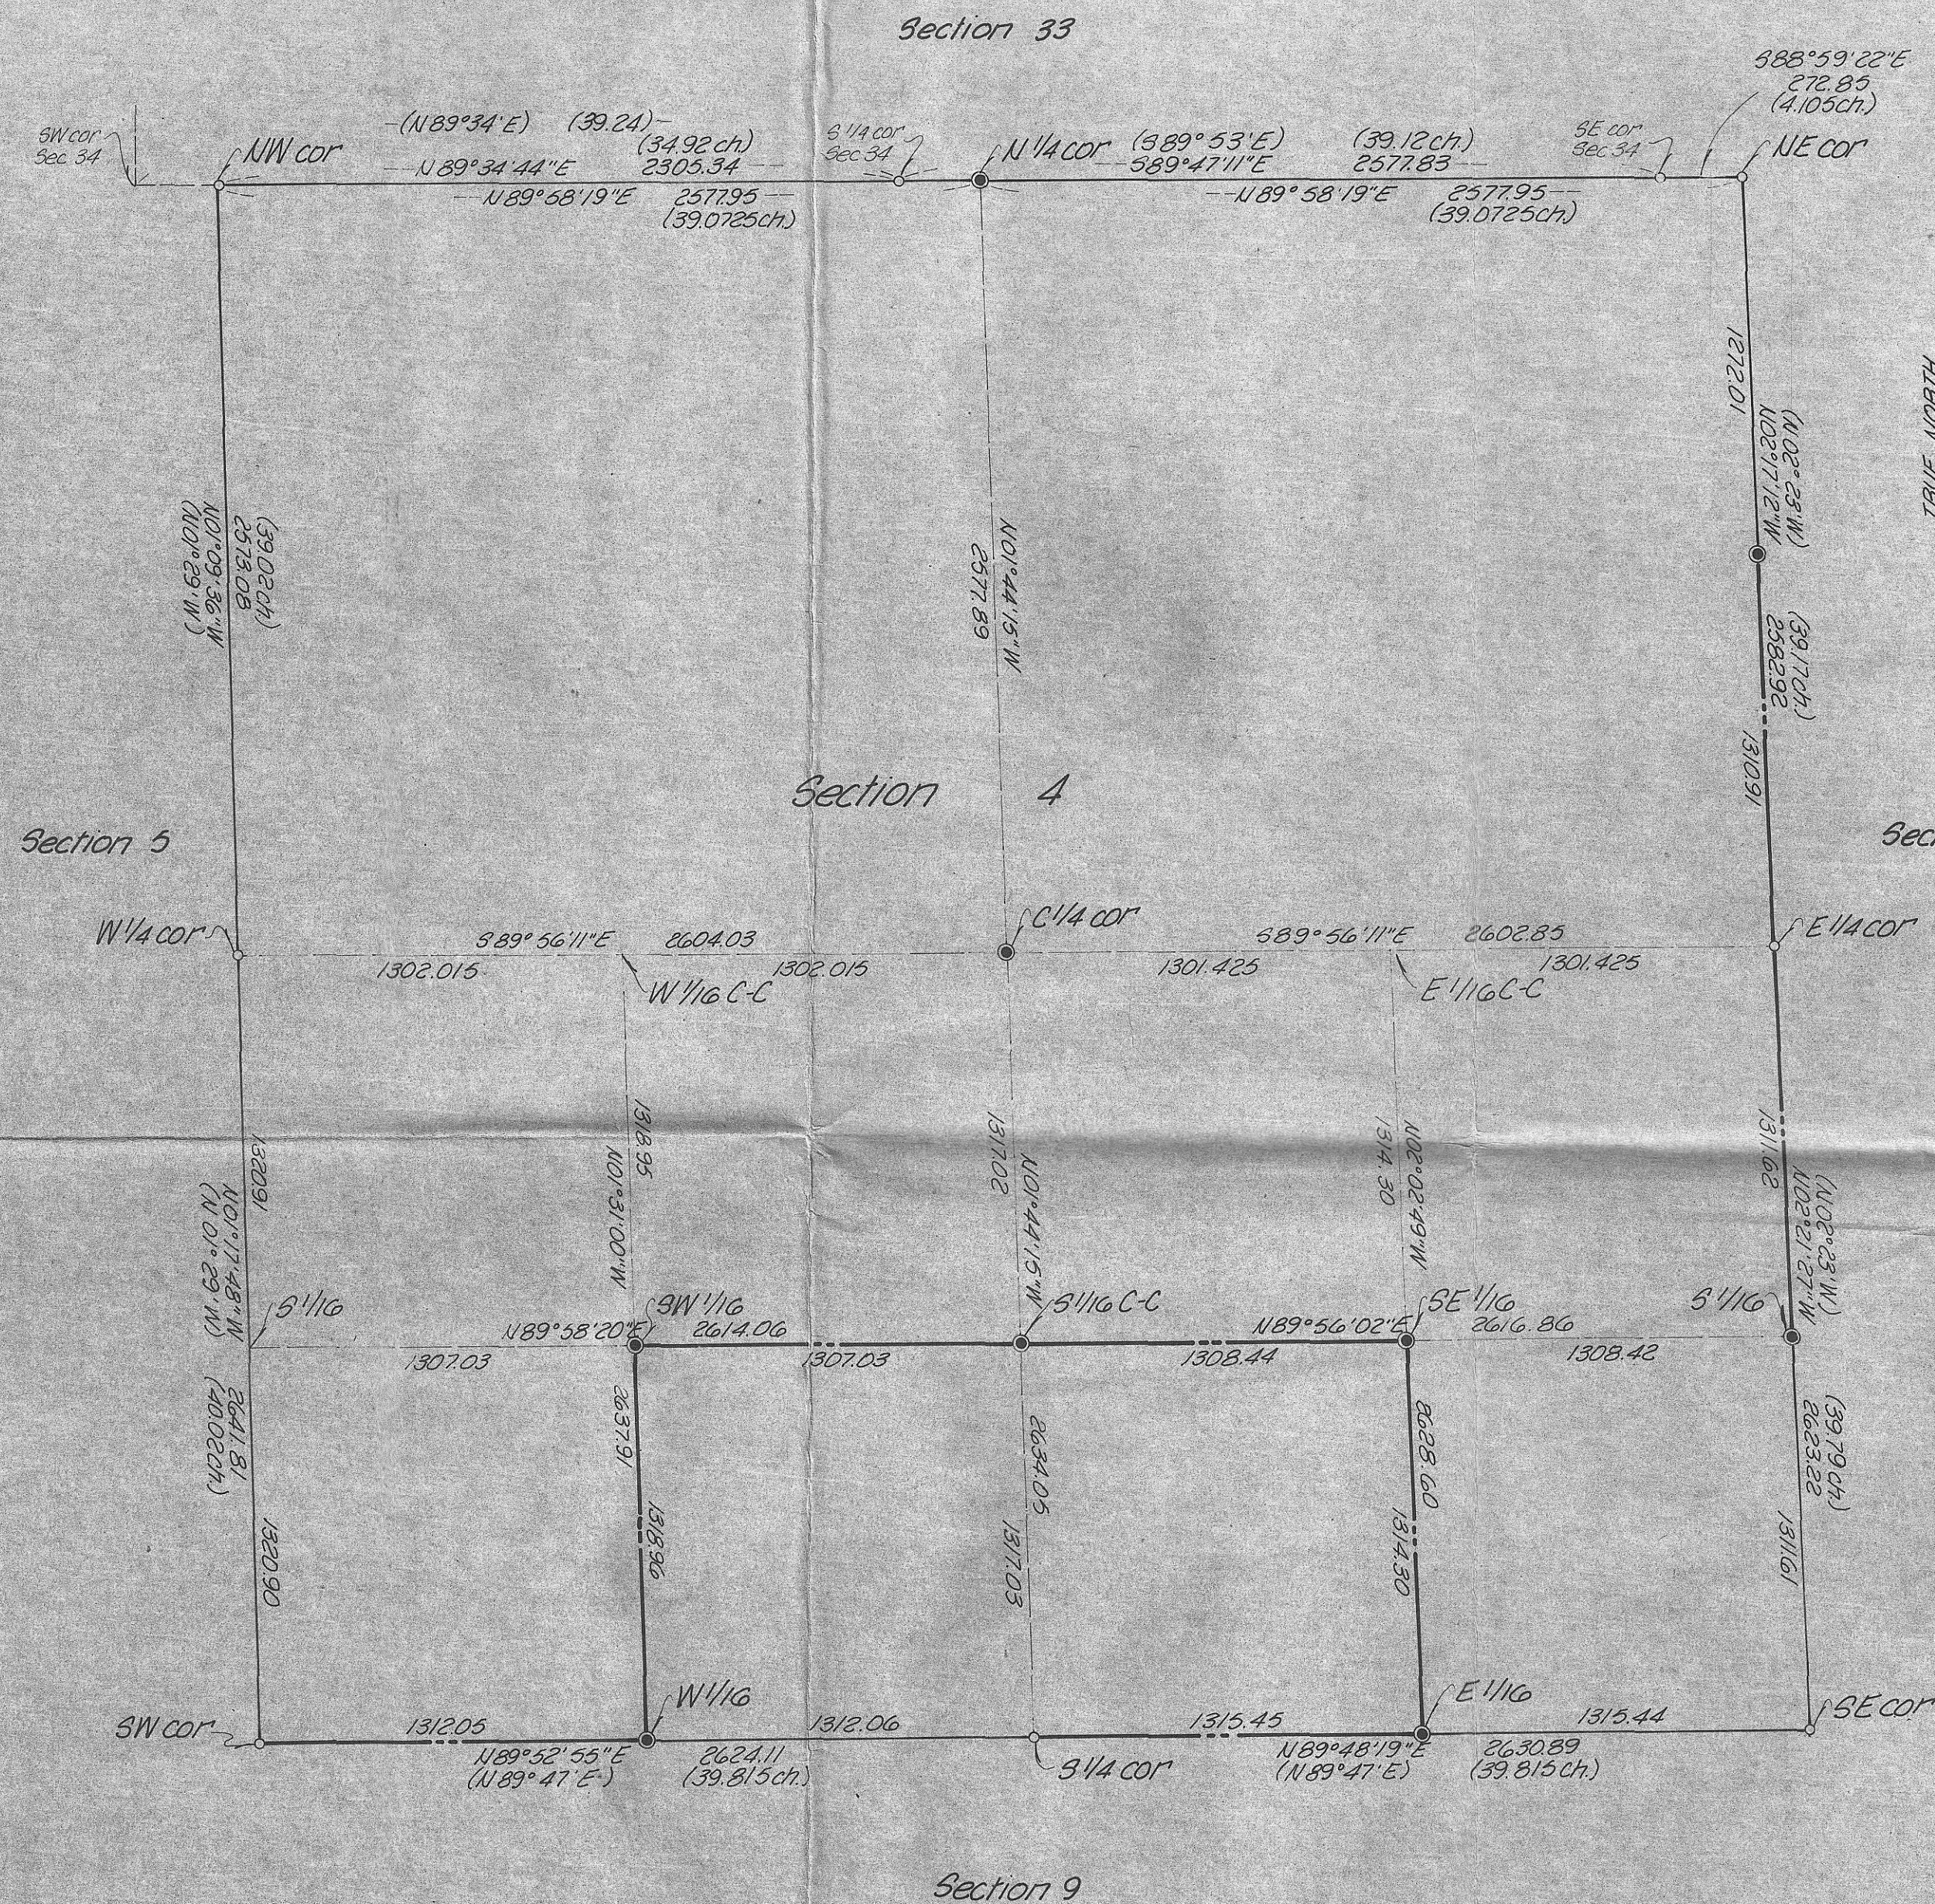

NOTES:

Bearings are based on survey plot drawing done by the U.S. Department of the Interior General Land Office, dated February 21, 1941. All bearings do not match the BLM. I used the bearing between the East one-quarter and Southeast corner of Section 10, Township 5 South, Range 28 East, W.M. All bearings and distances are true. This drawing is of one section out of five sections surveyed for the U.S. Forest Service.

All field notes on traverses for Section 4 are in Book 4. Notes used to set Brass caps are in Book 4, pages 189-201. Accessory ties for all corners set are described in Certified Record of Land Monumentation.

All found corners are part of a closed traverse. See Traverse Detail Sheet 6 of 6. Computations for all corners set are based on the Manual of Surveying Instruction 1973, Chapter 5.

All lines posted were performed by the Offset Method from the traverse lines.

LEGAL DESCRIPTION

U.S. Forest Service ownership, all of Section 4, excepting the Southeast one-quarter of the Southwest one-quarter and the Southwest one-quarter of the Southeast one-quarter of Section 4, Township 5 South, Range 28 East of the Willamette Meridian, County of Morrow.

I, Terry E. Hamby, a registered land surveyor in the State of Oregon, hereby certify that this plot and the notes hereon, or attached, are a correct representation of a survey I performed during June thru October, 1979, for the U.S. Forest Service in accordance with the statutes of the State of Oregon and with the Articles of my contract.

Terry E. Hamby (s) Terry E. Hamby
Registered Land Surveyor
Oregon License 1638

REGISTERED
PROFESSIONAL
LAND SURVEYOR

Terry E. Hamby

- denotes Brass Cap set
- denotes Brass Cap found, set BLM 1939
- () denotes GLO record bearings & distances, 1939
- denotes Forest Service Boundary & posted line

Sheet 2 of 6

	KRUMBEIN ENGINEERING CO ENGINEERS - SURVEYORS - PLANNERS 221 S. Main, Pendleton, Oregon	SCALE 1" = 500'
		DATE Dec. 4, 1979
		DRN BY MAI
		CKD BY TEH
		DWG NO 79-73C
Survey for U.S. FOREST SERVICE Section 4, T5S, R28E, W.M.		

Job No. 79-87
79-87