


NOTES:

Bearings are based on survey plot drawing done by the U.S. Department of the Interior General Land Office, dated February 21, 1941. All bearings do not match the BLM. I used the bearing between the East one-quarter and Southeast corner of Section 10, Township 5 South, Range 28 East, W.M. All bearings and distances are true. This drawing is one section out of five sections surveyed for the U.S. Forest Service.

All field notes on traverses for Section 9 are in Book 4. Notes used to set Brass Caps are in Book 4, pages 62-73. Accessory ties for all corners set are described in Certified Record of Land Monumentation.

All found corners are part of a closed traverse, except as noted. See Traverse Detail Sheet 6 of 6. Computations for all corners set are based on the Manual of Survey Instruction, 1973, Chapter 5.

All lines posted were performed by the offset Method from the traverse lines.

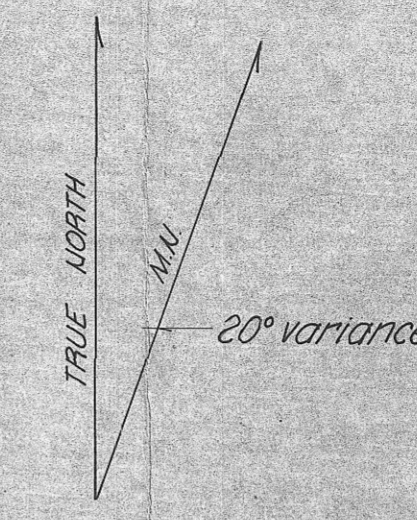

LEGAL DESCRIPTION

U.S. Forest Service ownership; all of Section 9, excepting the Northwest one-quarter of Section 9, Township 5 South, Range 28 East of the Willamette Meridian, County of Morrow.

I, Terry E. Hamby, a registered land surveyor in the State of Oregon, hereby certify that this plat and the notes hereon, or attached, are a correct representation of a survey I performed during June thru October, 1979, for the U.S. Forest Service in accordance with the statutes of the State of Oregon and with the Articles of my contract.

Terry E. Hamby (s) Terry E. Hamby
Registered Land Surveyor
Oregon License 1638

REGISTERED PROFESSIONAL LAND SURVEYOR

Terry E. Hamby

RECEIVED BY
Morrow County Surveyor
Date 12-15-79
Filed By MJ
No. #268-K-416

- denotes Brass Cap set
- denotes Brass Cap found, set BLM 1939
- () denotes GLO record bearings & distances, 1939
- denotes Forest Service Boundary & posted line

Sheet 3 of 6

K KRUMBEIN ENGINEERING CO ENGINEERS - SURVEYORS - PLANNERS 221 S. Main, Pendleton, Oregon	SCALE 1" = 500'
	DATE Dec 4, 1979
Survey for U.S. FOREST SERVICE	DRN BY MH
Section 9, T5S, R28E, W.M.	CKD BY TEH
	DRNG NO 79-73C