

- denotes Brass Cap set
- denotes Brass Cap found, set BLM 1939
- () denotes GLO record bearings & distances, 1939
- denotes Forest Service Boundary & posted line

NOTES:

Bearings are based on survey plot drawing done by the U.S. Department of the Interior General Land Office, dated February 21, 1941. All bearings do not match the BLM. I used the bearing between the East one-quarter and southeast corner of Section 10, Township 5 South, Range 28 East, W.M. All bearings and distances are true. This drawing is of two sections out of five sections surveyed for the U.S. Forest Service.

All field notes on the traverse for Section 10 are in Book 1. Notes used to set Brass Cap are in Book 4, pages 284-287. All field notes on traverses for Section 15 are in Book 4. Notes used to set Brass Caps are in Book 4, pages 266-282. Accessory ties for all corners set are described in Certified Record of Land Monumentation.

All corners found are part of a closed traverse. See Traverse Detail Sheets 5 of 6 and 6 of 6. Computations for all corners set are based on the Manual of Survey Instruction 1973, Chapter 5.

All lines posted were performed by the Offset Method from the traverse lines.

LEGAL DESCRIPTIONS

Section 10


U.S. Forest Service ownership; all of Section 10, Township 5 South, Range 28 East of the Willamette Meridian, County of Morrow.

Section 15

U.S. Forest Service ownership; all the Northwest one-quarter; the North half of the Southwest one-quarter; the Northwest one-quarter of the Southeast one-quarter; all the Northeast one-quarter, excepting the Southeast one-quarter of the Northeast one-quarter of Section 15, Township 5 South, Range 28 East of the Willamette Meridian, County of Morrow.

I, Terry E. Hamby, a registered land surveyor in the State of Oregon, hereby certify that this plat and the notes hereon, or attached, are a correct representation of a survey I performed during June thru October, 1979, for the U.S. Forest Service in accordance with the statutes of the State of Oregon and with the Articles of my contract.

Terry E. Hamby (s) Terry E. Hamby
Registered Land Surveyor
Oregon Licensee 1638

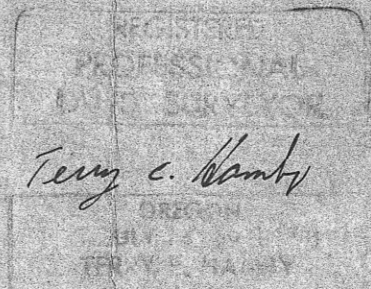

RECEIVED BY
Morrow County Surveyor
Date 12-10-79
Rec'd By mjt
No. # 269-K-417

Sheet 4 of 6

KRUMBEIN ENGINEERING CO ENGINEERS - SURVEYORS - PLANNERS 221 S. Main, Pendleton, Oregon	SCALE 1" = 300'
	DATE Dec 4, 1979
Survey for U.S. FOREST SERVICE	DRN BY MH
3 1/2 Section 10, & Section 15, T5S, R28E, W.M.	CKD BY T.E.H.
	DRNG NO. 79-730

