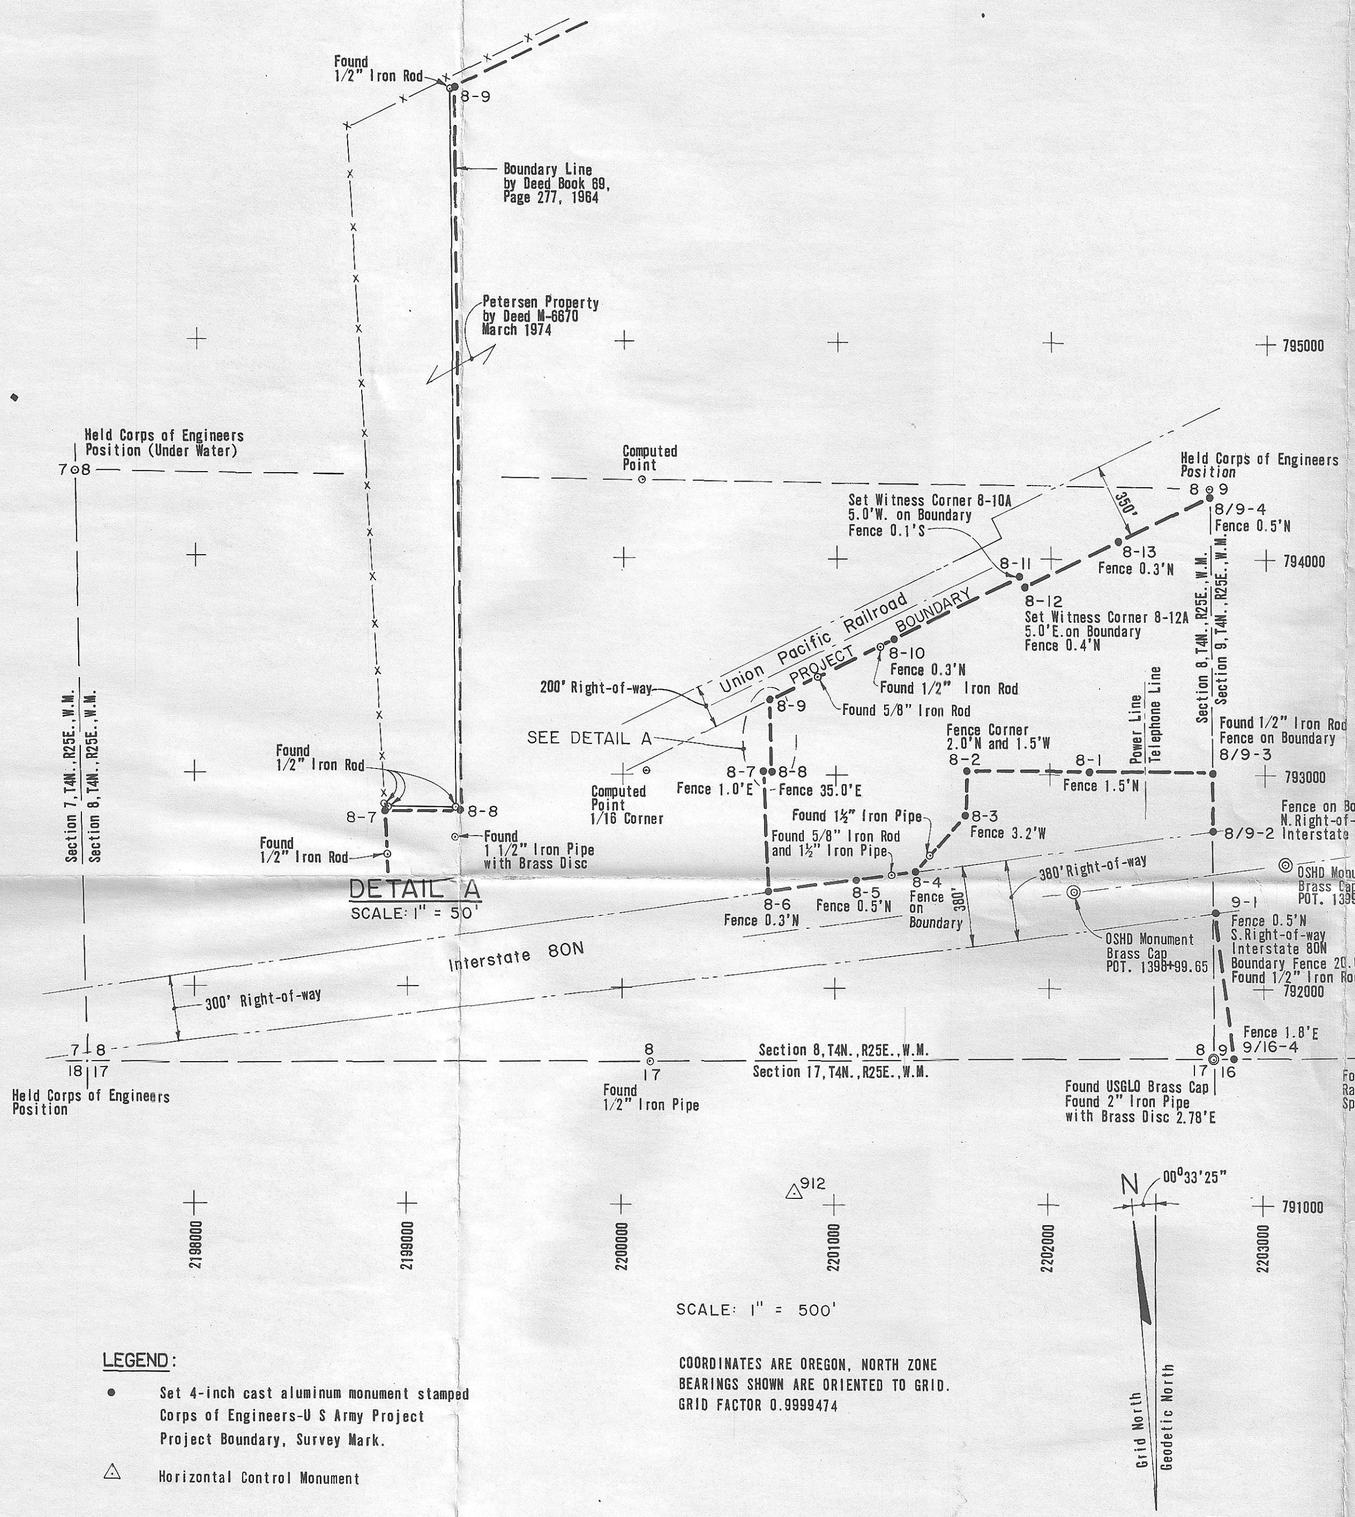

MARK	NORTHING	EASTING	BEARING	DISTANCE	RECOVERY RECORD
Section 8 Boundary					
W. ¼ Corner	794393.72	2197438.99			
			S01°09'04" E	2753.94'	
S.W. Corner	791640.34	2197494.32			
			N89°38'38" E	2638.43'	
S. ¼ Corner	791656.74	2200132.70			
			N89°30'27" E	2646.65'	
S.E. Corner	791679.49	2202779.25			
			N00°26'33" W	2644.74'	
E. ¼ Corner	794324.16	2202758.82			
			N89°15'03" W	2660.14'	
Center	794358.94	2200098.91			
			N89°15'03" W	2660.14'	
W. ¼ Corner	794393.72	2197438.99			
Center	794358.94	2200098.91			
			S00°43'00" E	1351.20'	
1/16 Corner	793007.84	2200115.80			
			S00°43'00" E	1351.20'	
S. ¼ Corner	791656.74	2200132.70			
Section 9 Boundary					
W. ¼ Corner	794324.16	2202758.82			
			S00°26'33" E	2644.74'	
S.W. Corner	791679.49	2202779.25			
			S89°16'37" E	2608.47'	
S. ¼.Corner	791646.57	2205387.52			
Project Boundary					
9/16-4	791678.36	2202869.24			
			N07°38'49" W	679.72'	
9-1	792352.03	2202778.79			
			N01°09'09" W	382.39'	
8/9-2	792734.34	2202771.10			
			N00°26'33" W	267.49'	
8/9-3	793001.83	2202769.03			
			N89°52'12" W	576.54'	
8-1	793003.13	2202192.50			
			N89°52'12" W	576.54'	
8-2	793004.44	2201615.96			
			S00°43'00" E	200.00'	
8-3	792804.46	2201618.46			
			S42°29'04" W	348.71'	
8-4	792547.30	2201382.95			
			S81°43'23" W	280.00'	
8-5	792506.99	2201105.86			
			S81°43'23" W	420.00'	
8-6	792446.52	2200690.24			
			N02°20'00" W	560.53'	
8-7	793006.59	2200667.42			
			S89°52'12" E	35.91'	
8-8	793006.51	2200703.33			
			N00°43'00" W	334.16'	
8-9	793340.64	2200699.15			
			N64°15'03" E	644.35'	
8-10	793620.57	2201279.52			
			N64°15'03" E	639.36'	
8-10A Witness Corner	793898.32	2201855.39			
			N64°15'03" E	5.00'	
8-11	793900.50	2201859.89			
			S25°44'58" E	50.00'	
8-12	793855.46	2201881.61			
			N64°15'02" E	5.00'	
8-12A Witness Corner	793857.64	2201886.11			
			N64°15'02" E	482.15'	
8-13	794067.10	2202320.39			
			N64°15'02" E	487.15'	
8/9-4	794278.73	2202759.17			
Horizontal Control Monument					
912	791054.04	2200815.95			
913	791362.67	2204339.17			

LEGEND:

- ● Set 4-inch cast aluminum monument stamped Corps of Engineers-U S Army Project Project Boundary, Survey Mark.
- △ Horizontal Control Monument

COORDINATES ARE OREGON, NORTH ZONE
BEARINGS SHOWN ARE ORIENTED TO GRID.
GRID FACTOR 0.9999474

JOHN DAY PROJECT BOUNDARY

BOARDMAN AREA

By CH2M HILL INC.

For The CORPS OF ENGINEERS

SECTIONS 8 AND 9, T 4N., R 25E., W.M.

MORROW COUNTY OREGON

Surveyed March 1979 **Sheet 1 of 1**

REGISTERED PROFESSIONAL LAND SURVEYOR
Kenneth R. Wengler
OREGON JULY 13, 1973 KENNETH R. WENGLER 1002

C-275-K-420

RECEIVED BY
Morrow County Surveyor
4-10-79
S Barth
C-#275-K