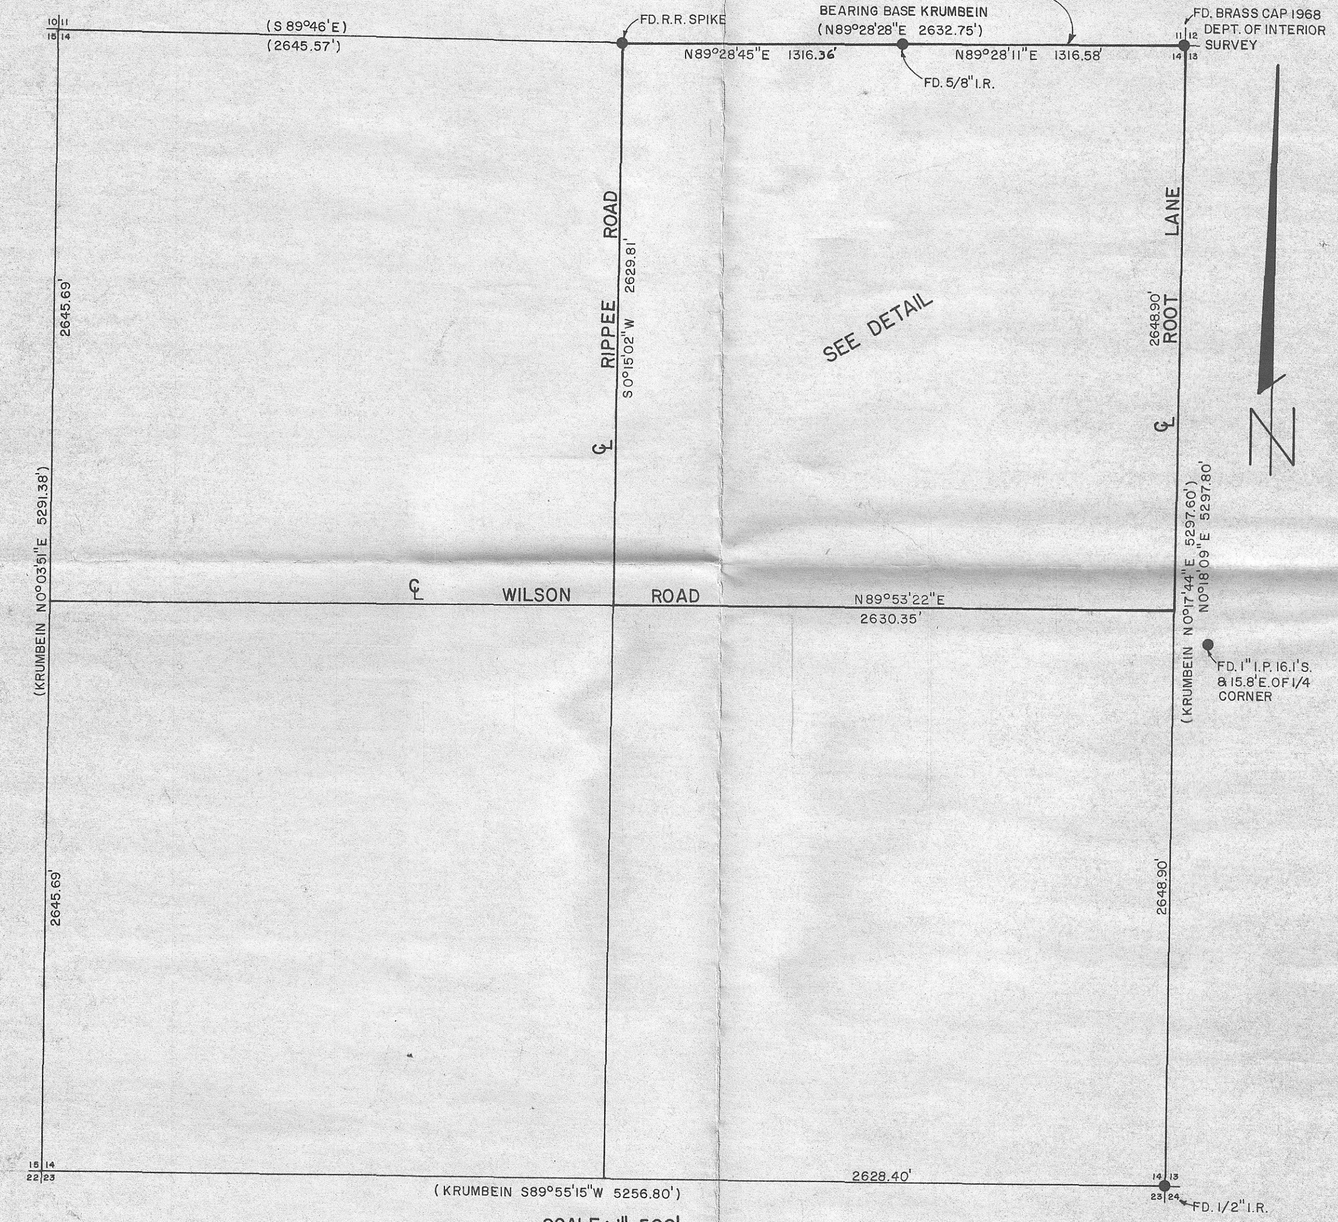

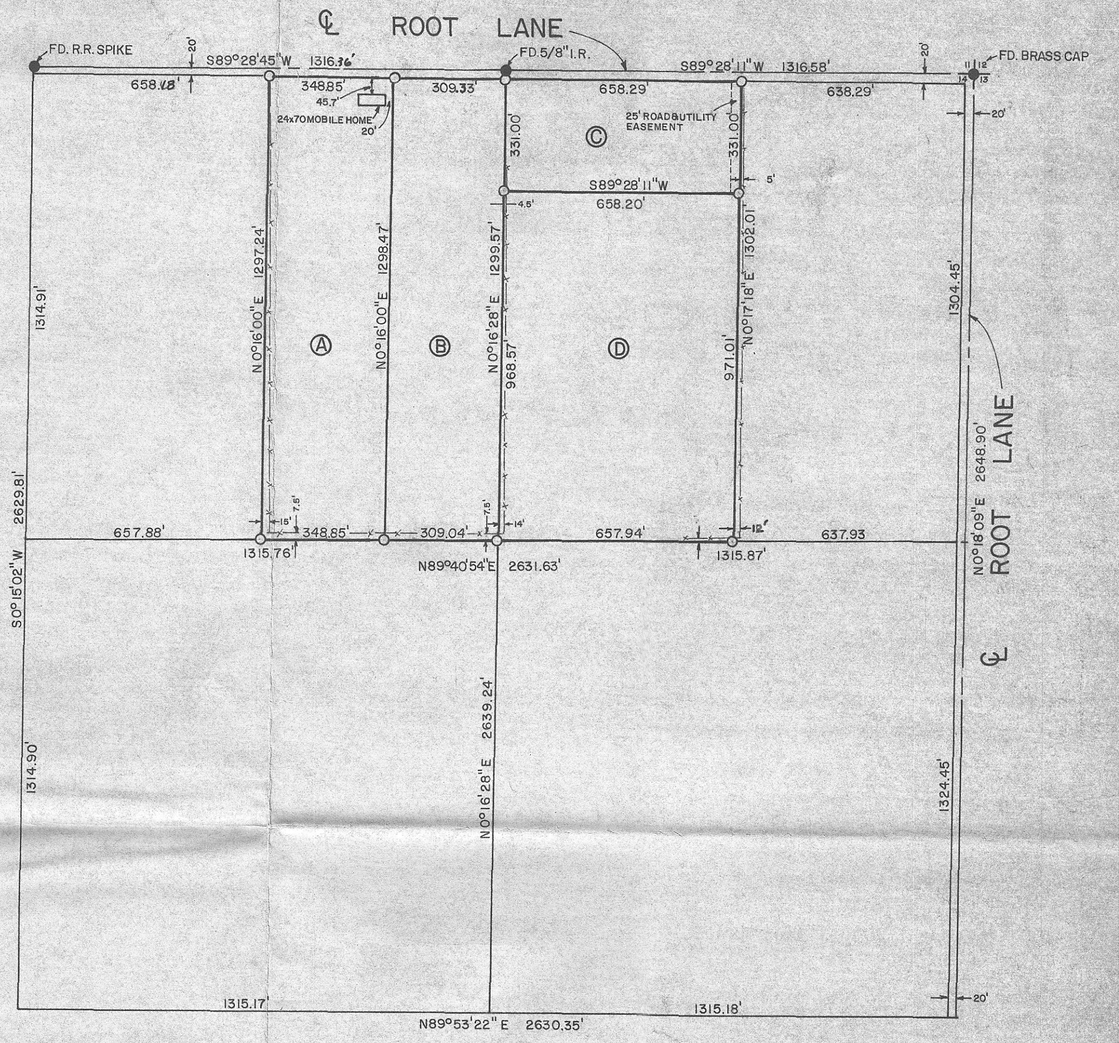

BEARINGS & SURVEY ARE BASED ON
1977 KRUMBEIN SURVEY FOR DOCKEN

RECEIVED BY
Morrow County Surveyor
Date 2-28-80
Rec'd By
No. #282-K

REGISTERED
PROFESSIONAL
LAND SURVEYOR
G. Dennis Edwards
OREGON
JULY 16, 1971
G. DENNIS EDWARDS
951

C-282-K-426

SURVEY FOR: JOHN GRADY

LOCATION: NE 1/4, SECTION 14, T4N, R25E., W.M.
MORROW COUNTY, OREGON

DATE: 1-24-80 SCALE: AS SHOWN

● MONUMENTS FOUND (000) OF RECORD

O 1/2" IRON RODS SET JOB Nº S8001013

EDWARDS SURVEYING
567-3336
P.O. BOX 763
HERMISTON, OREGON