

CURVE DATA

No.	Radius	Arch	Chord	Chord Bearing
1	11649.16	989.55	989.25	576°42'25"W
2	11649.16	76.83	76.83	574°05'05"W

- denotes Brass Screw and Washer, stamped $\frac{1}{8}$ 16 4U, 25E found
- denotes $\frac{1}{8}$ in. iron pin set
- denotes $\frac{1}{8}$ in. iron pin found, set by Wayne O. Harris during survey for the Port of Morrow
- denotes $\frac{1}{8}$ in. iron pins found, set by Richard Rogers
- () Bearing and distance of record

NARRATIVE


The purpose of this survey was to break out a 40.00 acre tract of land owned by the Port of Morrow.

The North line of the property runs along the top of the bank of the Columbia River as it existed on June 17, 1981.

Bearings are based on a survey by Wayne O. Harris for the Port of Morrow, dated July 30, 1969.

Bearings are grid and distances are true.

Grid $\theta = -00^{\circ}34'45"$
 Grid = 0.9999619

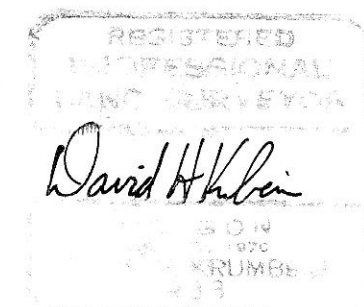

RECEIVED BY
 Morrow County Surveyor
 Date July 23, 1981
 Rec'd By M. Hughes
 No. C-425-K

Revised December 8, 1981 - MAJ
 Revised August 28, 1981 - MAJ

K KRUMBEIN ENGINEERING CO. ENGINEERS - SURVEYORS - PLANNERS 221 S. Main, Pendleton, Oregon	SCALE 1"=200'
	DATE June 18, 1981
	DRN. BY MAJ
	CKD. BY D.H.K.
	DRNG. NO. 81-30C

Survey for
PORT OF MORROW
 Section 3, T4N, R25E, W.M.