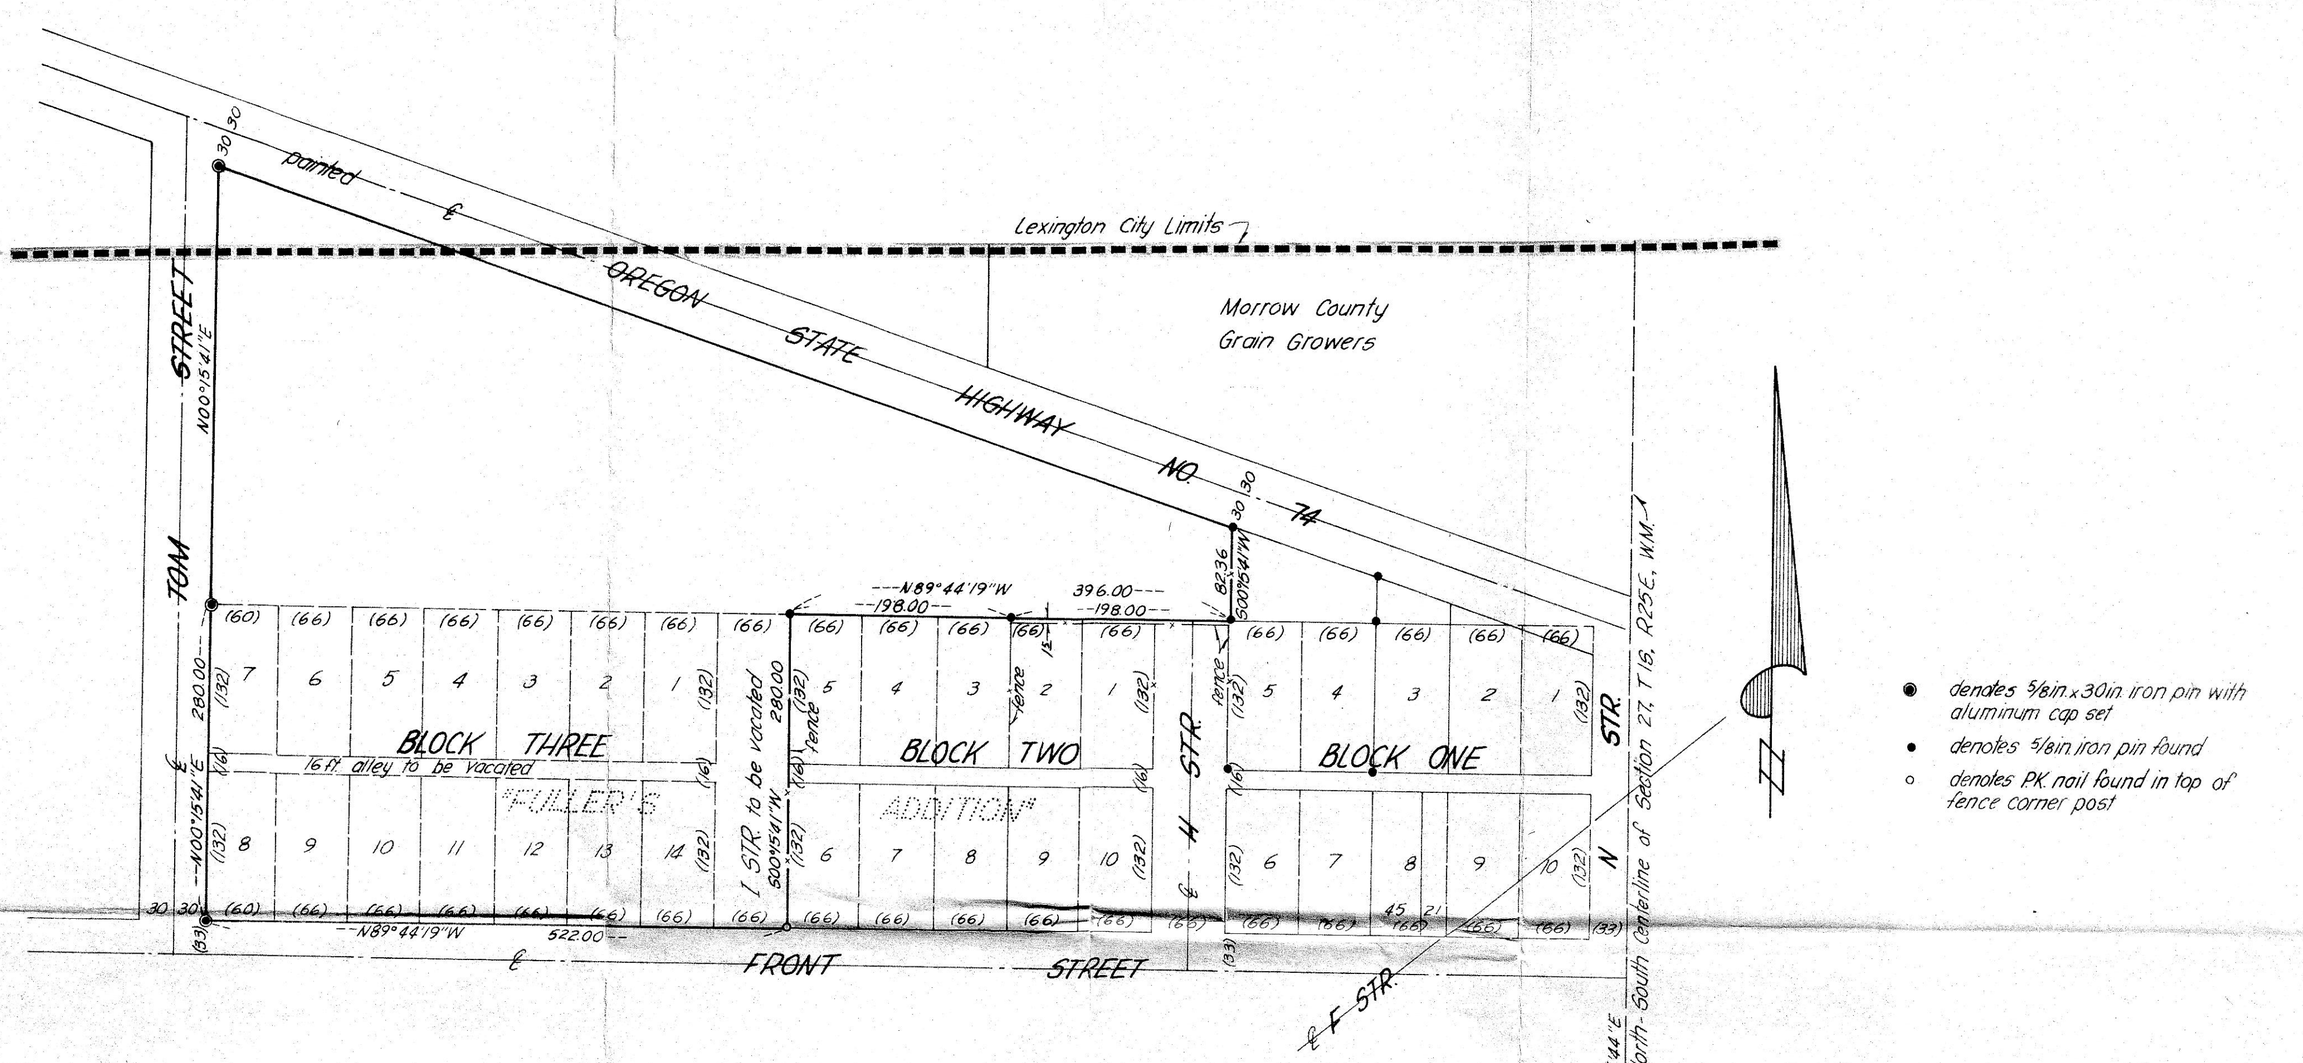

NARRATIVE

The purpose of this survey was to establish the boundaries of the property in the NE¼ of the SW¼ of Section 27, Township 1 South, Range 25 East, W.M., belonging to the Morrow County Road Dept. Using pins previously set by Krumbein Engineering, Ltd. in 1979 in "Fuller's Addition," we established the pins as shown. The painted centerline of Oregon State Highway No. 74 was accepted as the centerline of the 60 foot right-of-way, no other monuments being available.

Bearings are based on a survey for Orwick, Peterson, Wood, and Starr, by Krumbein Engineering, Ltd., dated June 5, 1979, Morrow County Survey Records drawing no. D-256-K.

RECEIVED BY
Morrow County Surveyor
Date November 22, 1982
Rec'd By M. Hughes
No. C-516-K

REGISTERED PROFESSIONAL LAND SURVEYOR
OREGON
DAVID H. KRUMBEIN
943

David H. Krumbein

KRUMBEIN ENGINEERING CO.
ENGINEERS – SURVEYORS – PLANNERS
221 S. Main, Pendleton, Oregon

Survey for
MORROW COUNTY ROAD DEPT.
located in NE¼, SW¼, Section 27, T1S, R25E, W.M.

SCALE 1" = 100'
DATE August 9, 1982
DRN. BY K.R.H.
CKD. BY MH
DRNG. NO. 82-27C

Job No. 82-93