CURVE DATA

No.	Radius	Arc	Tangent	Chord	Chord Bearing
1	64.80	125.08	93.57	106.55	N 82°54'55"E
2	114.80	174.00	108.64	152.82	N 71°02'24"E
3	706.46	182.44	91.73	181.93	S 55°01'56"E
4	756.46	187.67	94.32	187.19	S 40°31'37"E

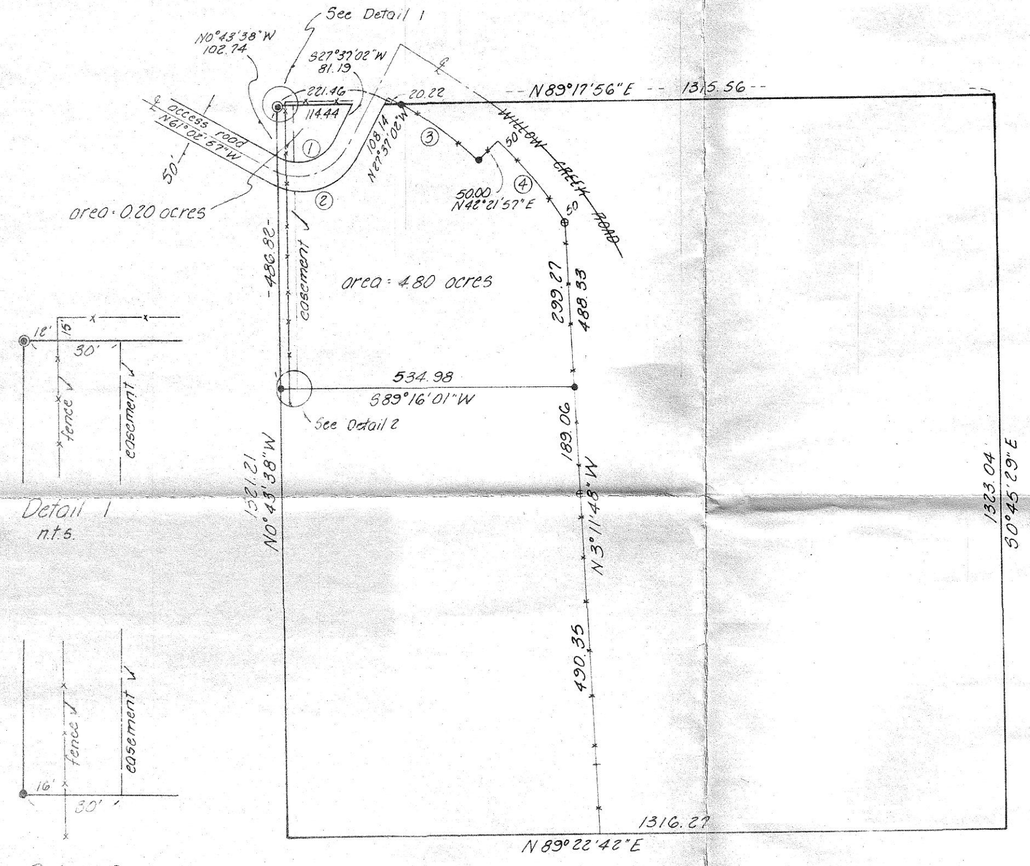

Detail 1
n.t.s.

Detail 2
n.t.s.

NE¼ of NW¼ of Sec. 2, T3S, R26E, W.M.
scale: 1" = 200'

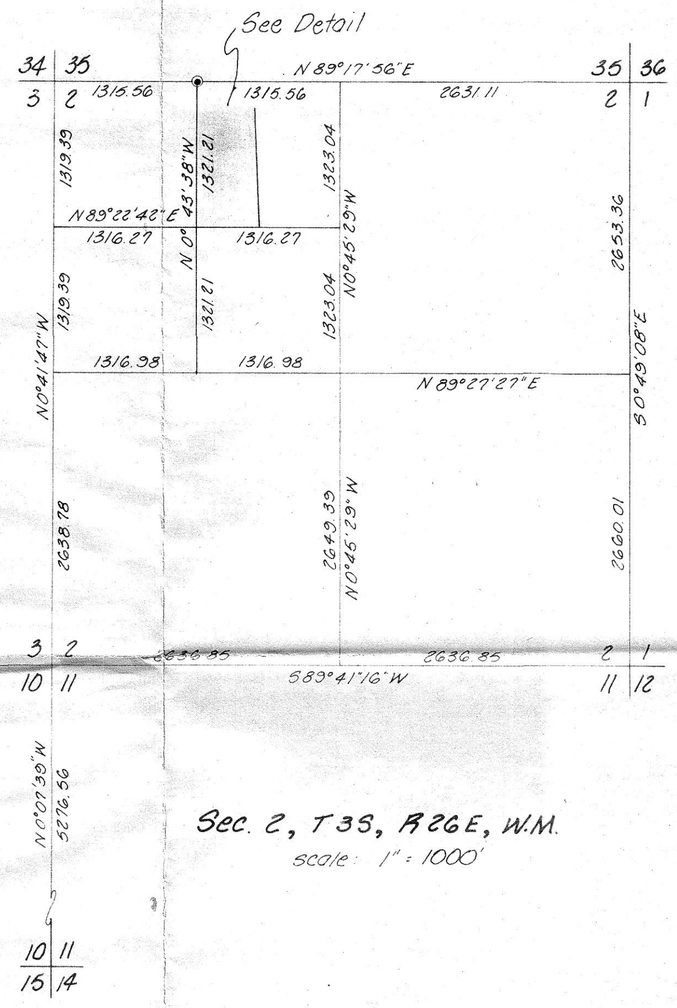

Sec. 2, T3S, R26E, W.M.
scale: 1" = 1000'

NARRATIVE:

The purpose of this survey was to divide off a 5.00 acre parcel in the Northwest quarter of the Northeast quarter of the Northwest quarter of Section 2, T. 3 S., R. 26 E., owned by Pete Lennon.

Control was based on the Corp of Engineers, Willow Creek Dam Boundary Survey, Morrow County Survey Drwg. No. D-524-K, bearings based on the same. Additional information supplied by the Project Engineers on-site office.

- ⊕ denotes aluminum cap found
- ◉ denotes Brass Cap set
- • denotes 5/8" x 30" iron pin w/alum cap set
- -x- denotes fence

C-529-K-[redacted]

KRUMBEIN ENGINEERING LTD. ENGINEERS – SURVEYORS – PLANNERS 361 S.E. Second Pendleton, Oregon	Scale as shown	Drn. By M.L.D.	Drng. No. 83-08C	Revision 1
	Date 2-25-83	Ckd. By D.H.K.	Job No. 83-17	Revision 2

Survey for

PETE LENNON

NE¼ of NW¼ of Sec. 2, T3S, R26E, W.M.

APPROVED BY
Morrow County Surveyor
2-28-83
M.L.D.
C-529-K

REGISTERED PROFESSIONAL LAND SURVEYOR
David H Krumbein