



○ DENOTES 5/8" X 30" IR. CAP SET  
 ● DENOTES MONUMENT FOUND AS NOTED

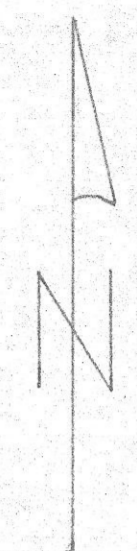

**NARRATIVE**

THE PURPOSE OF THIS SURVEY IS TO CREATE 3 PARCELS BY  
 MATCHING EXISTING FENCE LINES & CONG. IRRIGATION DITCH  
 LINES, AND SET THE CORNERS FOR THE 1 AC. PARCEL IN THE NW COR.  
 BASIS OF BEARINGS AS PER KRUMBEIN SURVEY FOR MORROW  
 CO. DATED 5-8-80.  
 MONUMENTS AND DISTANCES HELD AS PER KRUMBEIN  
 SURVEY AND TAMBLYN'S SUBDIVISION OF SEC. 23 T. 5 N., R. 26 W.

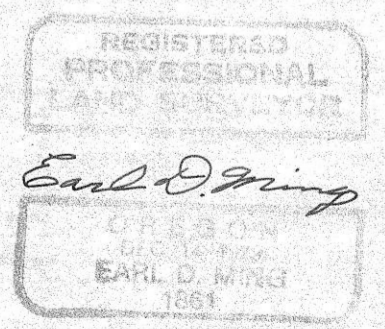

RECEIVED BY  
 Morrow County Surveyor  
 Date 3-29-83  
 Rec'd By M.L.D.  
 No. C-536-K

PART OF SEC. 23 T. 5 N., R. 26 E., MORROW COUNTY, OREGON	
SCALE: 1" = 100'	DRAWN BY EDM
DATE: 2-1-83	REVISED
SURVEY FOR CHARLES H. & GRACE E. WILLIS	
EDM SURVEYING PO BOX 709 IRRIGON, OR. 97844	DRAWING NUMBER 83-0111
PH. 922-3093	

C-536-K-477

FND. ALUM. CAP. KRUMBEIN  
 SURVEY FOR MORROW CO.  
 DATED 5-8-80