
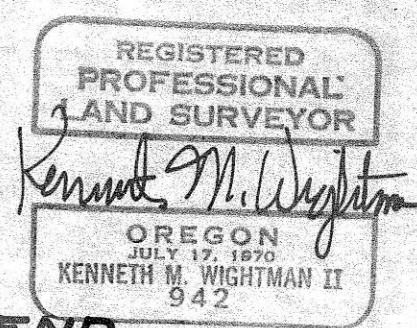


SEE SHEET 2 OF 2 FOR NARRATIVE & LAMBERT COORDINATES

**CERTIFICATION:**

"We, James M. Griffis and Kenneth M. Wightman, registered land surveyors in the State of Oregon, hereby certify that this plat and the notes hereon, or attached, are a correct representation of a survey we performed during June thru August, 1983 at the request of the U.S. Army Corps of Engineers, in accordance with the statutes of the State of Oregon and with the Articles of our contract No. DACW 57-83-C-0074.

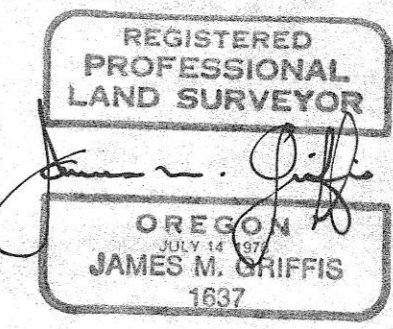

**LEGEND**

- Corner Set as indicated
- AM = "Bernstein" Aluminum Monument w/ breakaway base
- BD = 3/4" Bronze Disc grouted in rock
- SK = 2" Aluminum "Surv-Kap" set on 5/8" x 30" Iron Rod
- Monument Found as noted
- ⊙ Public Land Survey Corner Found as noted
- ⊠ Original G.L.O. Corner now lost and position derived from previous survey data
- Corps Project Boundary
- Right of Way Boundary
- Extended Control Line
- Centerline of Road
- ( ) Record data per G.L.O. (Thompson, Pengra & David) 1869
- (( )) Record data per Verl Fraley C-198-K
- [ ] Record data per Corps of Engineers Lambert Coordinates Oregon North Zone

All bearings are TRUE and all distances are GEODETIC unless otherwise noted. GRID TRUE +0°30'14" Scale 1" = 500' S.F. = 0.99996486

**DETAIL**  
Not to Scale

**DETAIL**  
Not to Scale

RECEIVED BY  
Morrow County Surveyor  
Date 11/30/93  
Rec'd By DHK  
No. C-644-K

**Timberland** **McCullough**  
ENGINEERS SURVEYORS FORESTERS PLANNERS  
1010 Airport Road, S.E. • P.O. Box 668 • Albany, OR 97321  
(503) 926-9404 Offices in Albany • Bend • McMinnville • Sunriver

Reference Segment "25" of the John Day Dam Real Estate drawings  
**RECORD OF SURVEY**

FOR: U.S. ARMY CORPS OF ENGINEERS  
LOCATED IN SECTION 15, TOWNSHIP 4 NORTH, RANGE 24 EAST,  
W.M., MORROW COUNTY, OREGON

JULY 30, 1983 - OCTOBER 14, 1983

Para. 2.12

C-644-K-488