
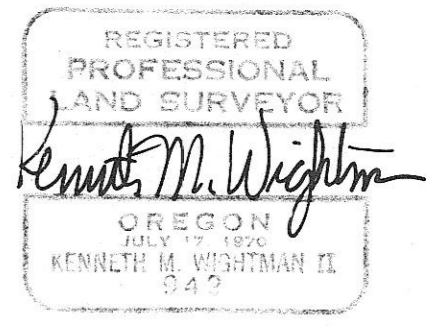


CERTIFICATION:

"We, James M. Griffis and Kenneth M. Wightman, registered land surveyors in the State of Oregon, hereby certify that this plat and the notes hereon, or attached, are a correct representation of a survey we performed during June thru August, 1983, at the request of the U.S. Army Corps of Engineers, in accordance with the statutes of the State of Oregon and with the Articles of our contract No. DACW-57-83-C-0074.

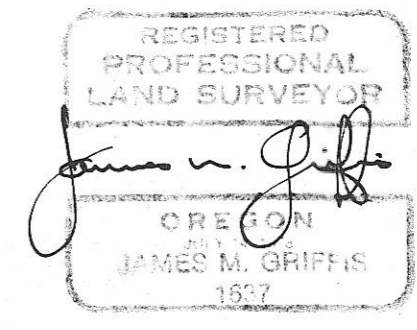

Scale = 1" = 500'
S.F. = 0.9999786
All bearings are TRUE and all distances are GEODETIC unless otherwise noted

LEGEND

- Corner Set as indicated
- AM = "Bernstein" Aluminum Monument w/ breakaway base
- BD = 3 1/2" Bronze Disc grouted in rock
- SK = 2" Aluminum "Surv-Kap" set on 5/16" x 30" Iron Rod
- Found Concrete Monument from Worthington's 1906 Plat of Subdivision of Section 20
- ⊙ Public Land Survey Corner Found as noted
- ⊛ Original G.L.O. Corner now lost and position derived from previous survey data
- Corps Project Boundary
- Right of Way Boundary
- Extended Control Line
- - - Centerline of Road
- () Record data per Worthington's 1906 Plat of Section 20
- [] Record data per B.L.M. 1975 (Frank Tuers)

RECEIVED BY
Morrow County Surveyor
Date 11/30/83
Rec'd By JHK
No. C-646-K

Reference Segment "32" of the John Day Dam Real Estate drawings

RECORD OF SURVEY

FOR: U.S. ARMY CORPS OF ENGINEERS
LOCATED IN SECTION 20, TOWNSHIP 5 NORTH, RANGE 27 EAST, W.M., MORROW COUNTY, OREGON

JULY 30, 1983 -
OCTOBER 14, 1983

SEE SHEET 2 FOR DETAILS
SEE SHEET 3 FOR NARRATIVE AND
LAMBERT COORDINATES

Para. 2.14

C-646-K-491

Did not search for
as we were asked to
stay out until after
harvest