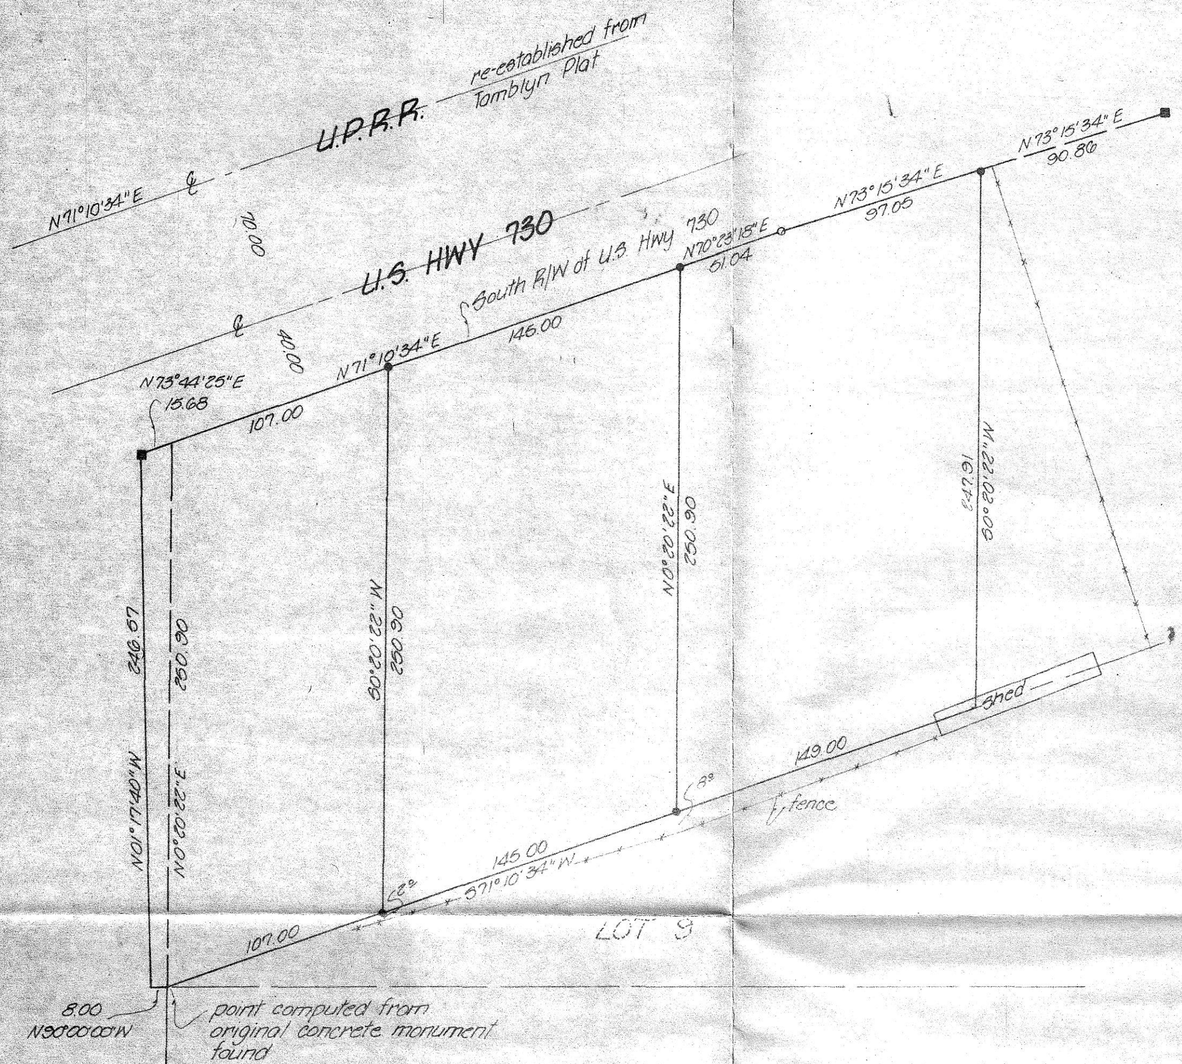

DETAIL

scale: 1"=50'

- ○ denotes set 5/8" x 30" iron pin with aluminum cap stamped PLS 933
- ■ denotes found 5/8" i.pin set by Edwards Surveying Morrow Co. No. A-625-K
- ○ denotes found 1/2" i.pin set by Edwards Surveying Morrow Co. No. D-383-K.
- ○ denotes found Brass Cap of BLM 1975
- ○ denotes found concrete monuments set by Tomblyn in 1935

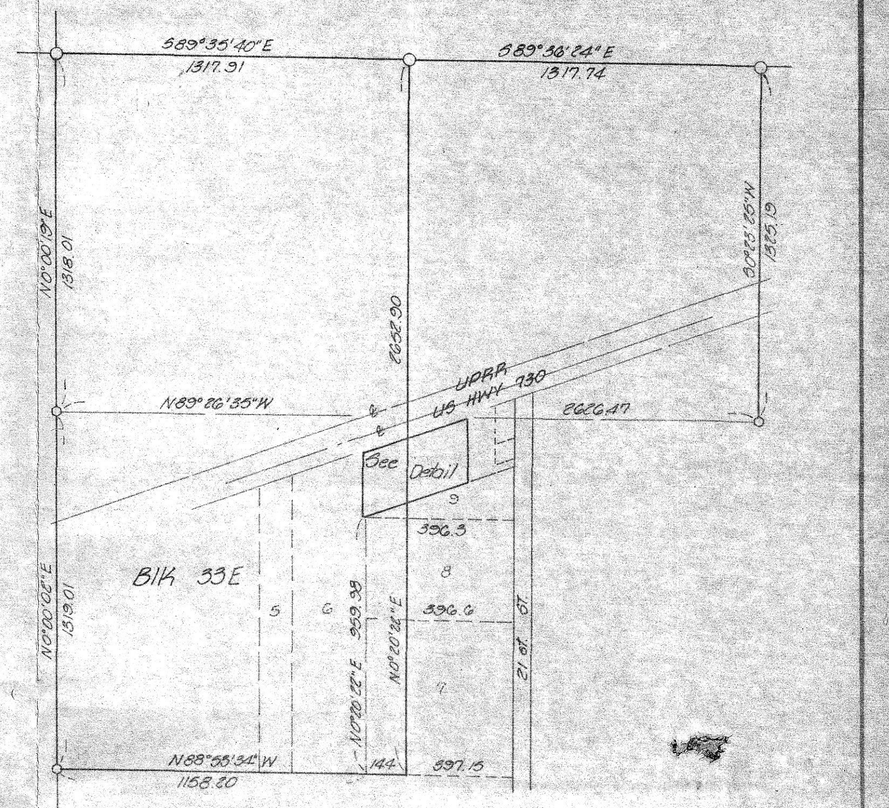

NW¼, SEC. 21, T5N, R27E, W.M.

scale: 1"=400'

NARRATIVE:

The purpose of this survey was to survey those parcels conveyed to Floyd D and Joan Smith as recorded in the Microfilm records of Morrow County and assigned Numbers 10682 and 18831. The survey is based on work done by the BLM in 1975 and the Corps of Engineers (County Surveyor No. C-646-K) in 1983. The section was then broken down in accordance with the Tomblyn plat as recorded in 1935.

Original concrete monuments were found as shown and used for the bearing base of N0°00'02"E as shown on County Surveyor No. C-646-K. Property corners set by Dennis Edwards as shown on County Surveyor No's D-383-K and A-625-K were found to not agree with the breakdown based on the old concrete monuments. It should be noted that the existence of these was not realized until 1979 and they are difficult to find having been set in 1906. Some of them are 3-8 feet deep.

C-679-K-[redacted]

KRUMBEIN ENGINEERING LTD.	Scale	Drn. By	Drng. No.	Revision 1
ENGINEERS — SURVEYORS — PLANNERS	as shown	MLD	84-85C	
361 S.E. Second Pendleton, Oregon	Date	Ckd. By	Job No.	Revision 2
	5-22-84	DHK	84-73	

Survey for

SMITH

REGISTERED PROFESSIONAL LAND SURVEYOR
David H Krumbein
OREGON
DAVID H. KRUMBEIN
1977

RECEIVED BY
COUNTY SURVEYOR
8/9/84
MLD
C-679-K

NW¼, Section 21, T5N, R27E, W.M.