

Record of Survey

A Tract of Land in City of Irrigon, Morrow County, Oregon

NARRATIVE

This survey is a tracing of an easement granted to Cascade Natural Gas Corporation by the City of Irrigon dated June 13, 1984 and recorded as microfilm No. 23459, Morrow County Deed Records.

The Basis of Bearing was established by survey ties to monument line for the centerline of Eighth Street which was determined to be $5^{\circ}00'10.45''$ E per survey R-2. The survey began at the section corner and followed the Bearings and distances called for in the easement.

REFERENCES


- R-1 Telek Engineering survey for City of Irrigon of a portion of the Oregon - Washington Railroad Right of Way, dated March 1983.
- R-2 Krumbein Engineering survey for Pacific Northwest Bell, dated September, 1981 ("B-437-K")
- R-3 Easement granted to Cascade Natural Gas Co. by City of Irrigon; recorded June 26, 1984 as microfilm No. 23459, Morrow County Records.

LEGEND

- Set $\frac{5}{8}$ " x 30" Iron Rod
- ▲ Found $\frac{5}{8}$ " Iron Rod stamped PLS 933, except for those monuments noted otherwise.

NOTE:
Bearing and Distance from actual corner of PNB tract to monument found, ($\frac{5}{8}$ " Iron Rod and Aluminum Cap stamped; Krumbein L5933)

| Corner | Bearing | Distance |
|--------|-------------------------|----------|
| ① | N $20^{\circ}21'56''$ W | 0.19' |
| ② | N $35^{\circ}09'08''$ W | 0.08' |
| ③ | N $45^{\circ}05'21''$ W | 0.09' |
| ④ | N $33^{\circ}15'05''$ W | 0.16' |

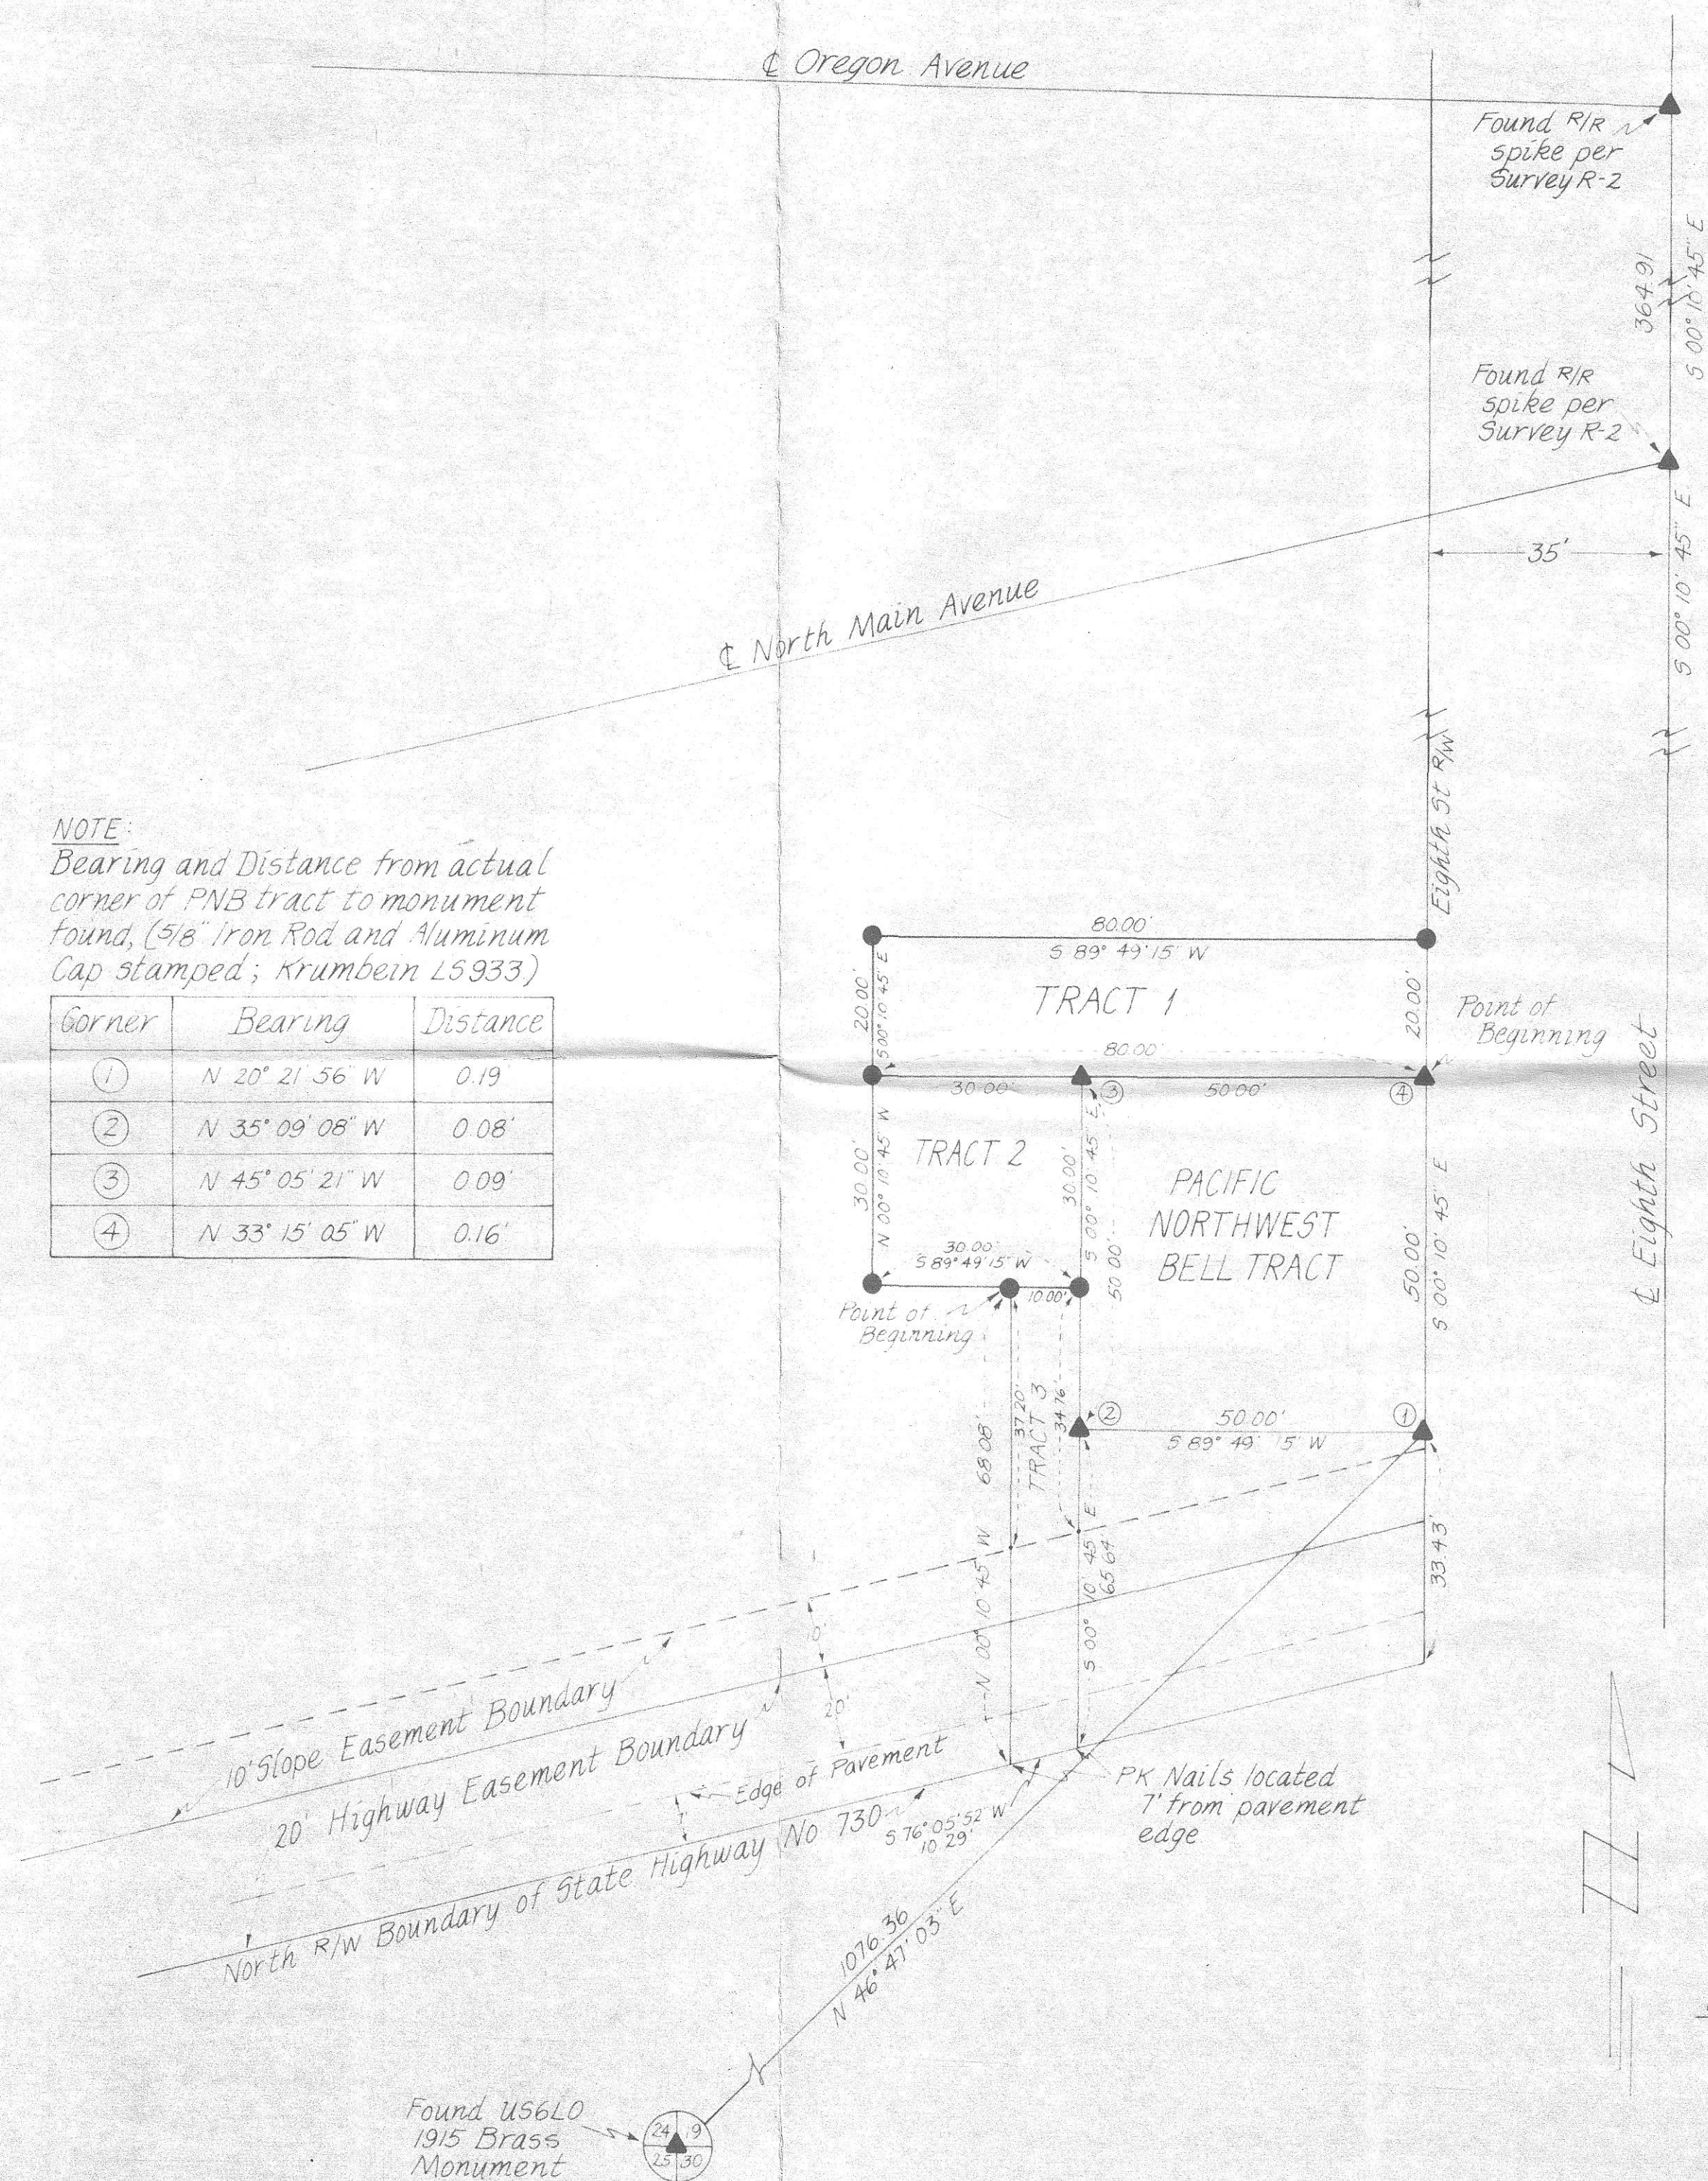

PROPOSED
LAW OFFICE
THOMAS J. HARRIS
ATTORNEY AT LAW
IRRIGON, OREGON

| | | | |
|--|---|-------------------|-------------------|
| prepared for: Cascade Natural Gas Corporation | | | |
| 222 Fairview Ave North Seattle, Washington | | | |
| RECEIVED BY Morrow County Surveyor Date 10-1-84 Rec'd By MLD No. C-680-K | TELEK ENGINEERING 540 SW 11TH STREET HERMISTON, OREGON 97838 | DATE July 1984 | SCALE 1" = 20' |
| | | REVISIONS | SHEET |
| | | DRAWN BY GE | 1 |

C-680-K-504