

SCALE 1" = 1500'

ALL BEARINGS & DISTANCES ARE GRID: SEE NOTES 1-3

DESCRIPTION

REFER TO MEMORANDUM FOR THE SECRETARY OF THE NAVY, DATED 9 JANUARY, 1961, SERIAL 34015:

MEMORANDUM FOR THE SECRETARY OF THE NAVY

SUBJECT: TRANSFER OF PORTION OF BOARDMAN AIR FORCE RANGE, OREGON, FROM DEPARTMENT OF THE AIR FORCE TO DEPARTMENT OF THE NAVY

1. PURSUANT TO REQUEST AND UNDER THE AUTHORITY CONTAINED IN TITLE 10, UNITED STATES CODE, SECTION 2571, THE DEPARTMENT OF THE AIR FORCE HEREBY TRANSFERS TO THE DEPARTMENT OF THE NAVY 58,372.90 ACRES OF FEE OWNED LAND AND 2.30 ACRES OF LESSER INTEREST AT THE BOARDMAN AIR FORCE RANGE, OREGON, TOGETHER WITH ALL IMPROVEMENTS THEREON AND ALL OF THE IMPROVEMENTS LOCATED ON THE PUBLIC DOMAIN LANDS WHICH ARE INTEGRAL PARTS OF THE BOARDMAN AIR FORCE RANGE, AS MORE PARTICULARLY DESCRIBED IN THE TRANSFER DOCUMENT ATTACHED HERETO. THIS TRANSFER INCLUDES ALL ACQUIRED LANDS AT THE RANGE EXCEPT FOR A 290-ACRE PARCEL OF UNIMPROVED FEE OWNED LAND, ALSO DESCRIBED IN THE TRANSFER DOCUMENT. SITUATED IN MORROW COUNTY, OREGON.

NOTES


1. BASIS OF BEARINGS: AERIAL CONTROL BY WALKER AND ASSOCIATES
2. BASIS OF COORDINATES: OREGON STATE PLANE COORDINATES - LAMBERT NORTH AS DETERMINED BY WALKER AND ASSOCIATES
3. GRID FACTOR = 0.9999436
4. REFER TO RECORDED SURVEYS BY:  
 HAYES AND HARRIS - 1965  
 JAMES J. OWENS - 1969  
 ANDERSON-PERRY AND ASSOCIATES - 1975  
 DONALD L. MCCONNELL - 1976  
 KRUMBEIN ENGINEERING CO. - 1976, 1978  
 COLLADAY SURVEYING - 1980
5. REFER TO SURVEY FOR U.S. NAVY BY SEA - 1978

REGISTERED PROFESSIONAL LAND SURVEYOR

Donald Cunningham

OREGON  
 DONALD C. CUNNINGTON  
 603

RECEIVED BY  
 Morrow County Surveyor  
 Date 5/16/86  
 Rec'd By MLD  
 No. C-810-K

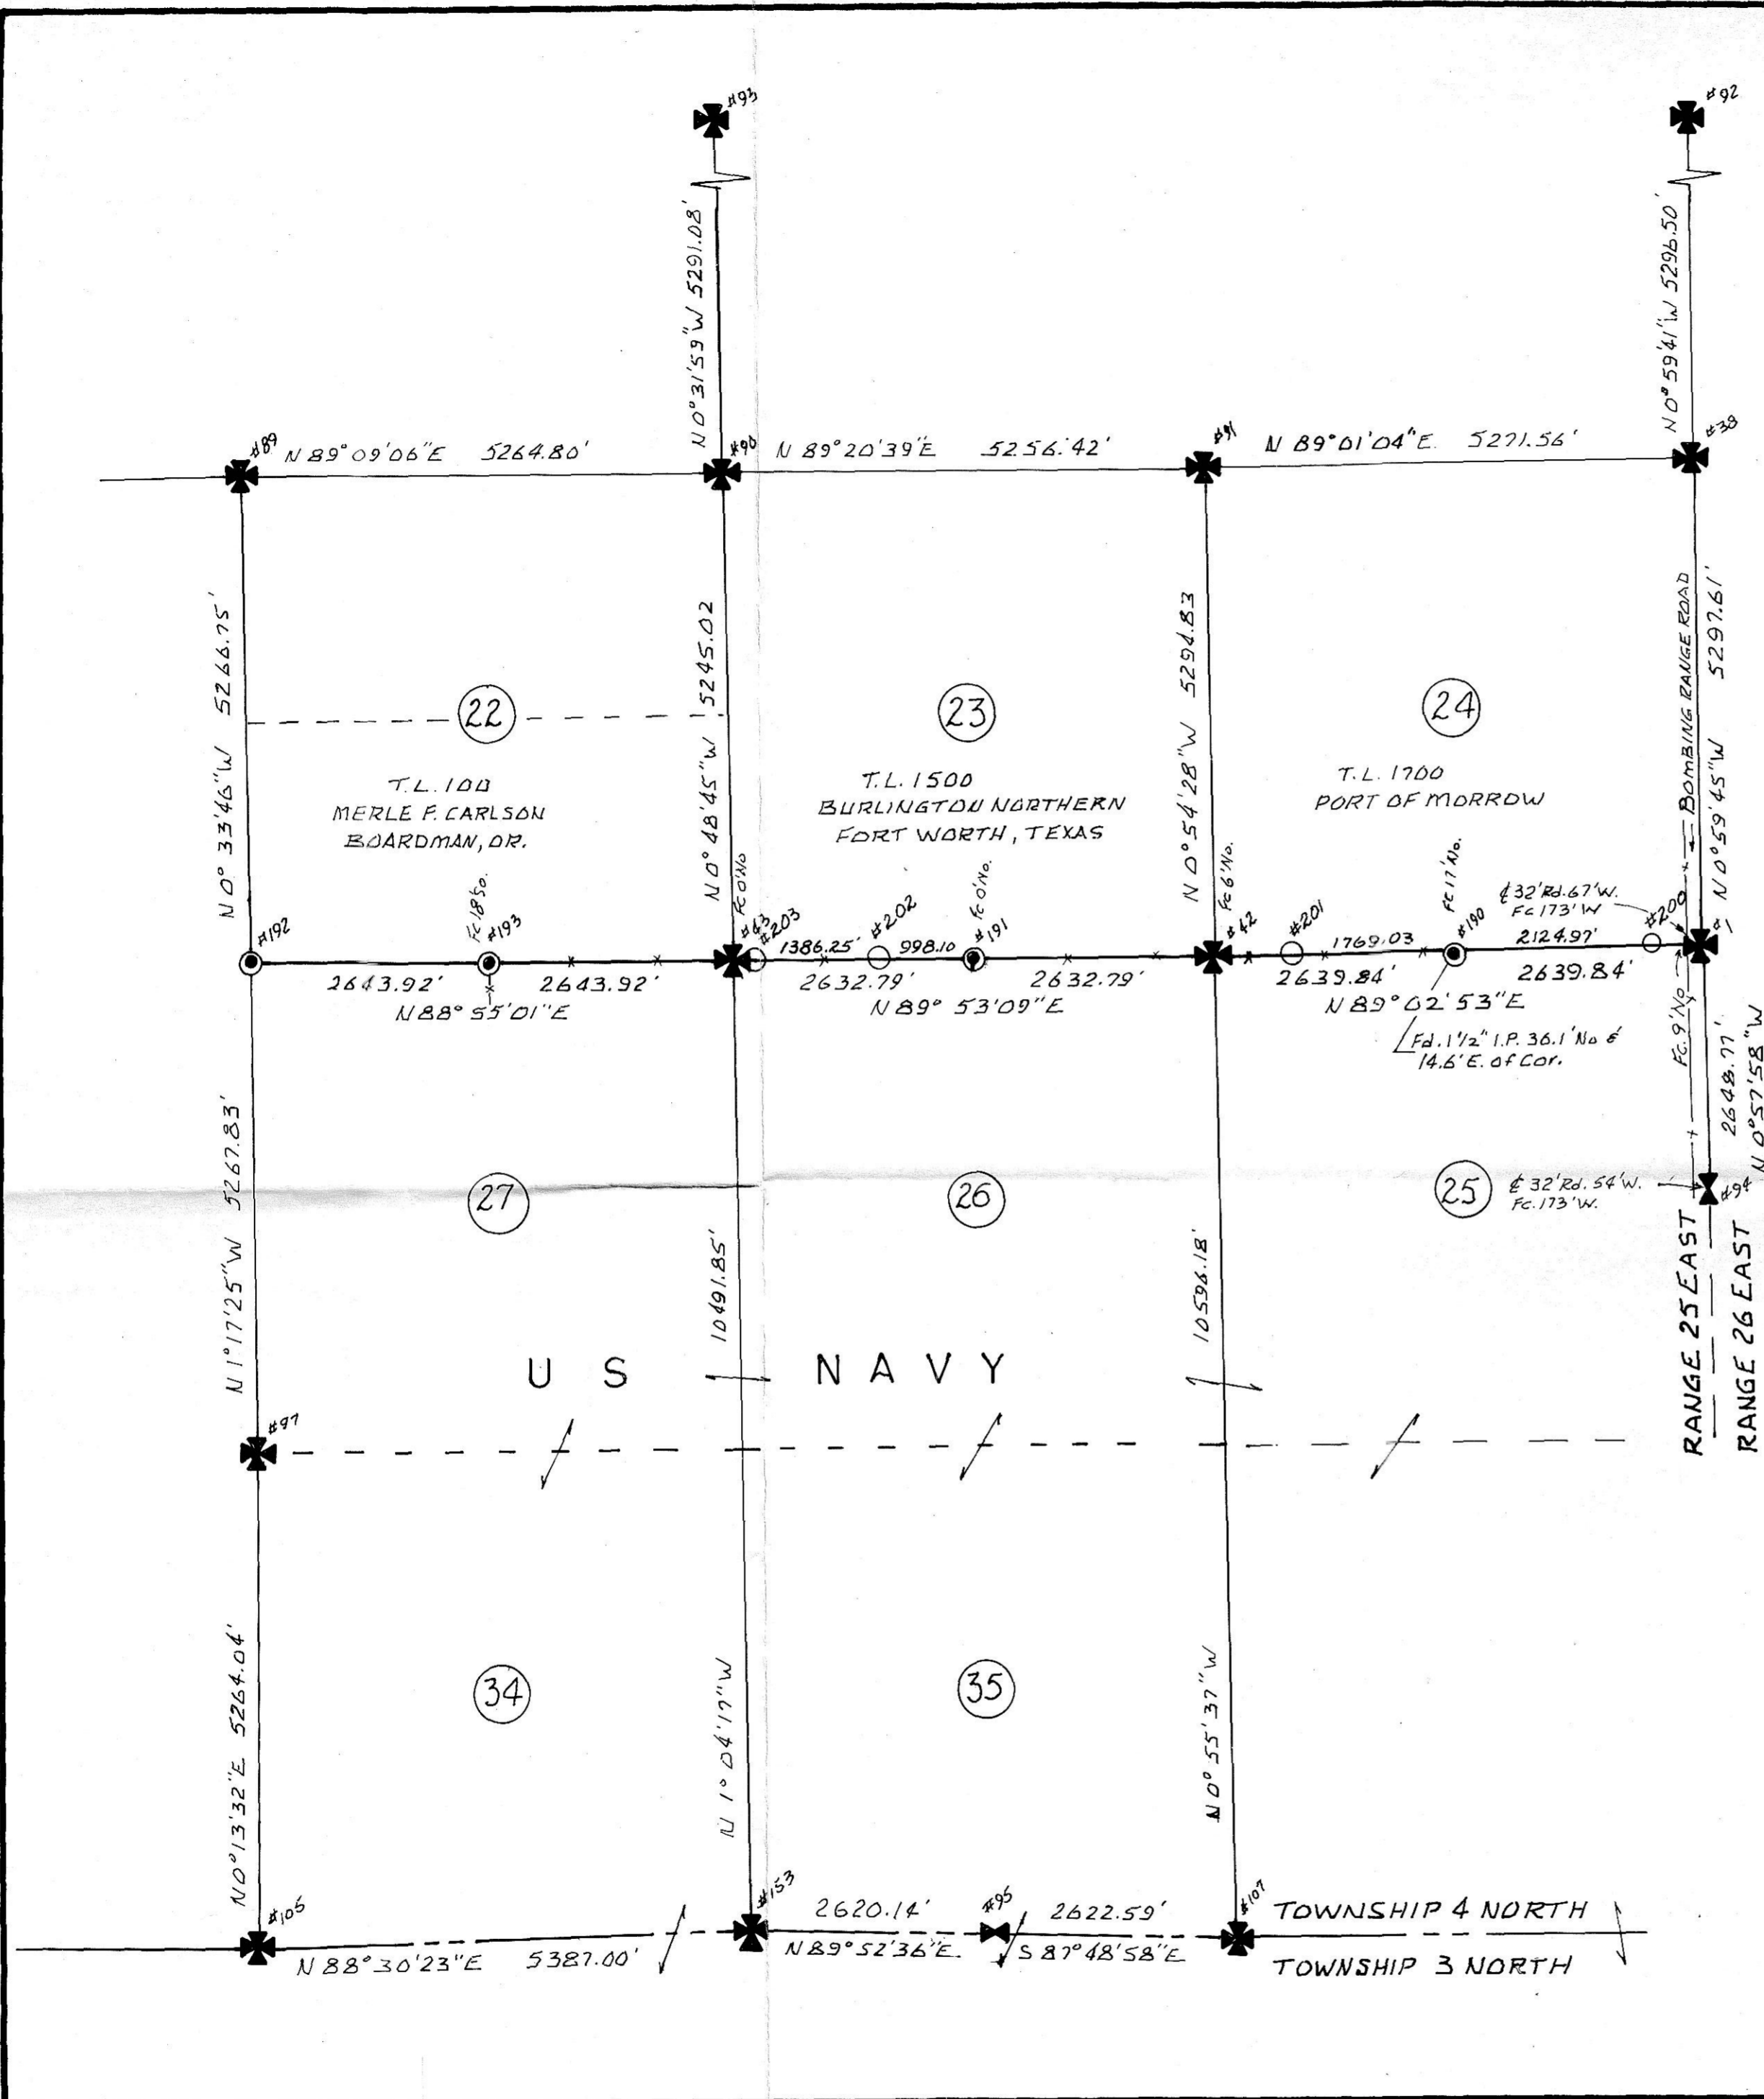

RECORDER'S CERTIFICATE

Filed for record this ..... day of ..... 19 ..... at ..... M  
 in book ..... of ..... at page ..... at the request of  
 ... P.O.O.L. ENGINEERING, INC. ...  
 Surveyor's Name

Mgr. Supt. of Records

SURVEYOR'S CERTIFICATE

This map correctly represents a survey made by me or under my  
 direction in conformance with the requirements of the Survey Recording  
 Act at the request of G. GILLIES, OIC USN, WEST DIV. NFEC...  
 in May, 19 86

DONALD C. CUNNINGTON  
 Certificate No. 603

**BOUNDARY SURVEY**  
 NAVAL WEAPONS SYSTEM TRAINING FACILITY  
 BOARDMAN, OREGON  
 FOR  
**U.S. DEPT. OF NAVY**  
 WESTERN DIVISION - NAVAL FACILITIES  
 ENGINEERING COMMAND CONTRACT NO. N 62474-85-D-0715

P O O L ENGINEERING INC. ONE PLAZA 10800 N.E. 8TH BOX 97033 BELLEVUE, WA 98009 PHONE: (206) 455-9494		
DWN BY D. CUNNINGTON	DATE MAY 1986	JOB NO. 20U750117
CHKD BY RML	SCALE 1" = 1500'	SHEET 2 OF 3

KUKER-BANKEN INC. 91907