PLAT OF PENLAND, 1988 CADASTRAL SURVEY

Section 33, T.4S., R.28E.,W.M.; Morrow Co., Oregon
U. S. D. A. Forest Service Contract No. 00-04R3-8-37
Refer to: Penland Cadastral Survey Field Notes, Books 1 & 2

N

MEAN. MAGNETIC DECLINATION = 18° E.

BASIS OF BEARING:
SOLAR OBSERVATION TAKEN
500' EAST of 1/4 CORNER 28/33

SCALE: FT. 0 600 1200 1800

SCALE: M. 0 200 400 600

◎ Corner found properly monumented, recorded.

○ Corner set this survey from original evidence; 2 1/2" x 30" alum. pipe with 2 1/2" alum. cap, certified record filed.

● Corner set this survey from measurement; 2 1/2" x 30" alum. pipe with 2 1/2" alum. cap; except as noted; certified record filed.

——— Forest boundary posted this survey

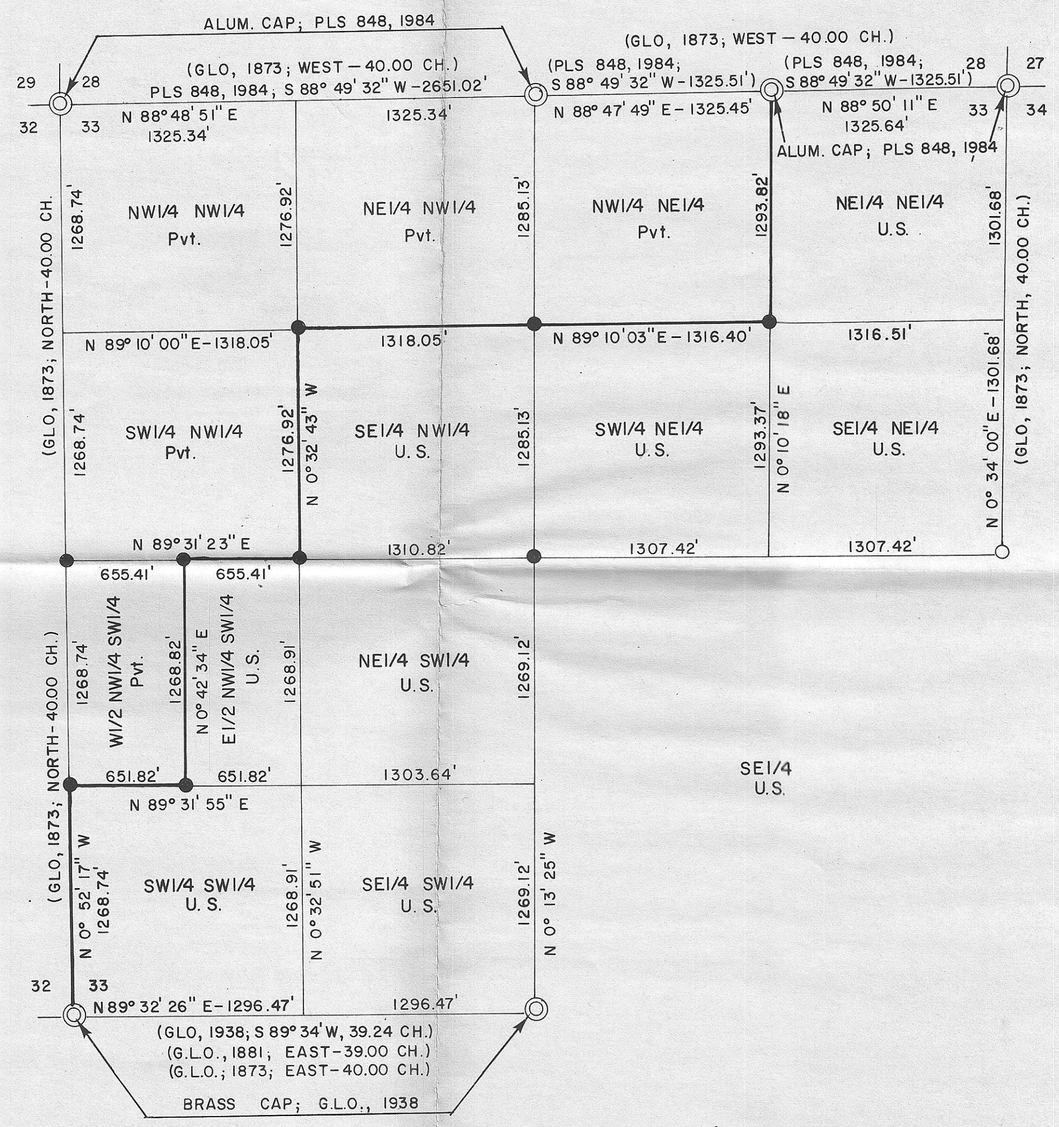

HISTORY AND NARRATIVE: Refer to Penland 1988 Cadastral Survey, Section 33, T.4S., R.28E.,W.M. – History and Narrative filed with this plat.

Certificate Of Survey

I, Fayette S. Munro, a Registered Professional Land Surveyor in the State of Oregon, hereby certify that this plat and the History and Narrative herein referred to are a correct representation of a Survey performed by me or under my direction during May and June, 1988 for the U.S. Forest Service, in accordance with the statutes of the State of Oregon and the articles of my contract.

Fayette S. Munro
Fayette S. Munro
Registered Professional Land Surveyor
Oregon License No. 1832

REGISTERED PROFESSIONAL LAND SURVEYOR
Fayette S. Munro
OREGON
JULY 14, 1972
FAYETTE S. MUNRO
1832

Examined and accepted for the U.S. Forest Service this 11TH day of October, 1988
Dennis L. Gaylord, C.O.R.

I certify that this survey was performed at the request of the Umatilla National Forest Supervisor.

O. Hanly Williams — 10/11/88
Signature — Date

RECEIVED BY
Morrow County Surveyor
Date 11-88
Rec'd By DHK
No. C 873K

C-873-K-540