


824,000

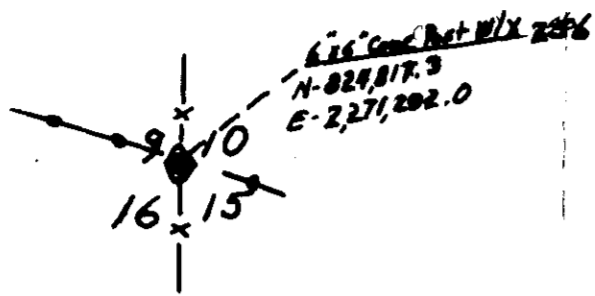

822,000

Eng-WASH  
 Umatilla NWR  
 T5N R27E  
 Scale 1"=400'  
 May 1970

C-2 T

2,272,000

C-2T-553

818,000

2,276,000